

Jackson
 M104
 10-16-66

MISSISSIPPI
 BOARD OF WATER COMMISSIONERS
 416 North State Street
 Jackson, Mississippi 39201

CODED

WATER WELL DRILLERS LOG

Oct 16 1966 White Water Supply Jackson
 d. of well completed firm name county well located


LANDOWNER: <u>S. G. Burdoy</u>	description of formations encountered	from	to
<u>Helena, Miss</u> (mailing address)	clay	0	16
WELL LOCATION: sec. <u>3</u> T. <u>6</u> N. R. <u>5</u> E. <u>5</u> miles <u>NE</u> of <u>Moreau</u> (distance) (direction) (nearest town)	sand	16	95
WELL PURPOSE: <u>Home</u> (home, irrigation, municipal, industrial)	clay	95	396
WELL COMPLETION DATA:	fine sand	396	410
(1) diameter (inches) <u>2"</u>	clay	410	890
(2) total depth (feet) <u>943</u>	sand	890	943
(3) static water level (feet) <u>31</u> <input checked="" type="checkbox"/> below <input type="checkbox"/> above top of ground.			
(4) casing <u>galv</u> (material) (depth)			
(size) If telescope see back.			
(5) screen <u>10'</u> , <u>933</u> (length) (depth to top)			
<u>2"</u> , <u>stainless</u> (size) (material)			
(6) pump <u>no pump</u> (HP) (yield gpm) <u>38 GPM</u>			
(type power)			
(7) electric log <u>no</u> (yes or no)			
(organization running log)			
(8) how well bottom plugged <u>B.P. Valve</u>			
DRILLERS REMARKS:			

APR 21 1969

MISS. BD. OF
 WATER COMM.

If well telescopes please sketch and show depths.

GROUND LEVEL

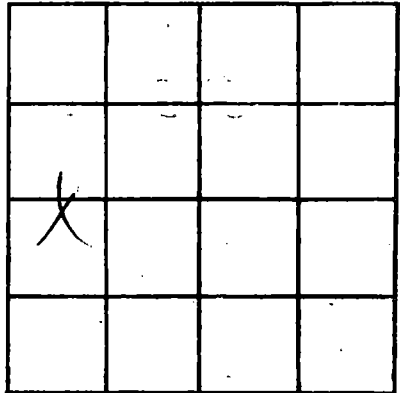

SECTION 33

Please indicate well location X.

ADDITIONAL INFORMATION

Lined area for additional information.

If more than one screen, show locations of each on sketch.