

Jackson
 M105
 11-8-66

MISSISSIPPI
 BOARD OF WATER COMMISSIONERS
 416 North State Street
 Jackson, Mississippi 39201

CODED

WATER WELL DRILLERS LOG

Nov 8 1966 Colville Water Supply Jackson
 date well completed firm name county well located

LANDOWNER: <u>Teroy Truader</u>	description of formations encountered	from	to
<u>Wolf Ridge</u> (mailing address)	<u>Clay</u> <u>sand</u>	<u>0</u> <u>22</u>	<u>22</u> <u>65</u>
WELL LOCATION: sec. <u>7</u> T. <u>6</u> N. R. <u>5</u> E. <u>8</u> miles <u>N</u> of <u>Moore Point</u> (distance) (direction) (nearest town)			
WELL PURPOSE: <u>home</u> (home, irrigation, municipal, industrial)			
WELL COMPLETION DATA:			
(1) diameter (inches) <u>2"</u>			
(2) total depth (feet) <u>65</u>			
(3) static water level (feet) <u>17</u> ^{below} above top of ground.			
(4) casing <u>galv</u> (material) (depth)			
(size) if telescope see back.			
(5) screen <u>5</u> <u>60</u> (length) (depth to top)			
<u>2"</u> <u>plastic</u> (size) (material)			
(6) pump (HP) (yield gpm)			
(type power)			
(7) electric log <u>no</u> (yes or no)			
(organization running log)			
(8) how well bottom plugged <u>BPU</u>			
DRILLERS REMARKS: <u>pump installed</u> <u>my owner</u>			


CODED

APR 21 1969

MISS. BD. OF
 WATER COMM.

If well telescopes please sketch and show depths.

GROUND LEVEL

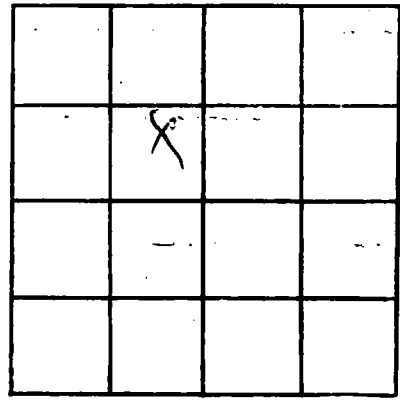

SECTION 7

Please indicate well location X.

ADDITIONAL INFORMATION

Lined area for additional information.

If more than one screen, show locations of each on sketch.