

Jackson
M 106
12-12-66

MISSISSIPPI
BOARD OF WATER COMMISSIONERS
416 North State Street
Jackson, Mississippi 39201

CODED

WATER WELL DRILLERS LOG

Dec 12 19 66 Cobalt Water Supply Jackson
date well completed firm name county well located

LANDOWNER: <u>Charles Temple</u>	description of formations encountered	from	to
<u>Wolf Ridge</u>	<u>sand</u>	<u>0</u>	<u>10</u>
(mailing address)	<u>clay</u>	<u>10</u>	<u>15</u>
WELL LOCATION:	<u>sand</u>	<u>15</u>	<u>32</u>
sec <u>9</u> T <u>6</u> N R <u>5</u> E <u>10</u> miles <u>NE</u> of <u>Moss Point</u> (distance) (direction) (nearest town)			
WELL PURPOSE: <u>home</u> (home, irrigation, municipal, industrial)			
WELL COMPLETION DATA:			
(1) diameter (inches) <u>1 1/4</u>			
(2) total depth (feet) <u>37</u>			
(3) static water level (feet) <u>10</u> below above top of ground.			
(4) casing <u>galv</u> (material) (depth)			
(size) if telescope see back.			
(5) screen <u>5'</u> (length) <u>32</u> (depth to top)			
<u>1 1/4</u> (size) <u>Copper gauze</u> (material)			
(6) pump (HP) (yield gpm)			
(type power)			
(7) electric log <u>no</u> (yes or no)			
(organization running log)			
(8) how well bottom plugged <u>BP Vahy</u>			
DRILLERS REMARKS: <u>pump installed by owner</u>			


CODED

APR 21 1969

MISS. BD. OF
WATER COMMS

If well telescopes please sketch and show depths.

GROUND LEVEL

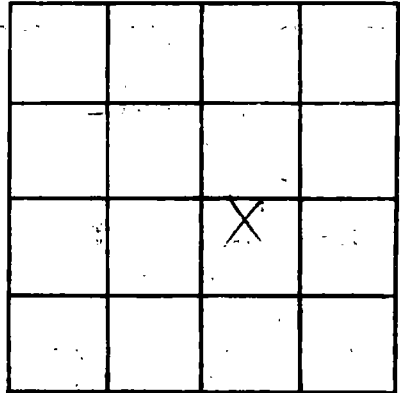

SECTION 9

Please indicate well location X.

ADDITIONAL INFORMATION

Lined area for additional information.

If more than one screen, show locations of each on sketch.