

Jackson
 M 106 107
 12-15-66

MISSISSIPPI
 BOARD OF WATER COMMISSIONERS
 416 North State Street
 Jackson, Mississippi 39201

CODED

WATER WELL DRILLERS LOG

Dec 15 1966 Cabille Water Supply Jackson
 day well completed firm name county well located


LANDOWNER: <u>Gumming</u>	description of formations encountered	from	to
<u>Boyers</u>			
<u>Helena Meise</u> (mailing address)	<u>clay</u>	<u>0</u>	<u>10</u>
WELL LOCATION:	<u>sand</u>	<u>10</u>	<u>100</u>
sec. <u>31</u> T. <u>6</u> N. R. <u>5</u> E.	<u>clay</u>	<u>300</u>	<u>578</u>
<u>6</u> miles <u>NE</u> of <u>M.P.</u>	<u>sand</u>	<u>578</u>	<u>590</u>
WELL PURPOSE: <u>home</u> (home, irrigation, municipal, industrial)			
WELL COMPLETION DATA:			
(1) diameter (inches) <u>2"</u>			
(2) total depth (feet) <u>590</u>			
(3) static water level (feet) <u>57'-6"</u> ^{below} above top of ground.			
(4) casing <u>galv</u> (material) (depth)			
(size) If telescope see back.			
(5) screen <u>10</u> <u>580</u> (length) (depth to top)			
<u>2"</u> <u>stainless</u> (size) (material)			
(6) pump _____ (HP) (yield gpm)			
(type power)			
(7) electric log <u>no</u> (yes or no)			
(organization running log)			
(8) how well bottom plugged <u>B.P. Valve</u>			
DRILLERS REMARKS: <u>pump installed by owner</u>			

APR 21 1969

MISS. BD. OF
 WATER COMM.

If well telescopes please sketch and show depths.

GROUND LEVEL

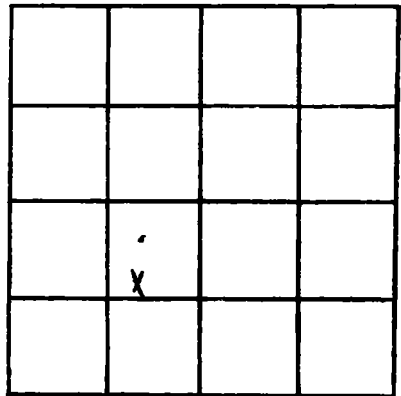

SECTION 31

Please indicate well location X.

ADDITIONAL INFORMATION

Lined area for additional information.

If more than one screen, show locations of each on sketch.