

Jackson
M108
3-21-67

MISSISSIPPI
BOARD OF WATER COMMISSIONERS
416 North State Street
Jackson, Mississippi 39201

CODED

WATER WELL DRILLERS LOG

March 20 1967 Cabille Water Sigs firm name Jackson county well located


LANDOWNER: <u>Helena Methodist Church</u>	description of formations encountered	from	to
<u>Helena Miss</u> (mailing address)			
WELL LOCATION: sec. <u>28</u> T. <u>6</u> N. R. <u>5</u> E <u>6</u> miles <u>NE</u> of <u>MP</u> (distance) (direction) (nearest town)	clay	0	10
WELL PURPOSE: <u>Church</u> (home, irrigation, municipal, industrial)	mud	10	40
WELL COMPLETION DATA:	clay	40	44
(1) diameter (inches) <u>2"</u>	sand	44	56
(2) total depth (feet) <u>215</u>	clay	56	110
(3) static water level (feet) <u>73</u> ^{below} above top of ground.	sand	110	142
(4) casing <u>galv</u> (material) _____ (depth)	clay	142	198
_____ (size) If telescope see back.	mud	198	215
(5) screen <u>5</u> (length) , <u>210</u> (depth to top)			
<u>2</u> (size) , <u>stainless</u> (material)			
(6) pump <u>1/2</u> (HP) , <u>6</u> (yield gpm)			
<u>elec</u> (type power)			
(7) electric log <u>no</u> (yes or no)			
_____ (organization running log)			
(8) how well bottom plugged <u>by Valer</u>			
DRILLERS REMARKS:			

APR 21 1969

MISS. BD. OF
WATER COMM.

If well telescopes please sketch and show depths.

GROUND LEVEL

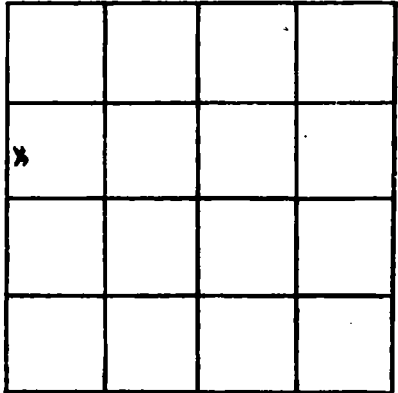

SECTION 28

Please indicate well location X.

ADDITIONAL INFORMATION

If more than one screen, show locations of each on sketch.