

Jackson  
 M 110  
 9-13-67

MISSISSIPPI  
 BOARD OF WATER COMMISSIONERS CODED  
 416 North State Street  
 Jackson, Mississippi 39201

WATER WELL DRILLERS LOG

9-13 1967 Cobell Water Sys Jackson  
 date well completed firm name county well located


LANDOWNER: <u>Mrs Porter</u>	description of formations encountered	from	to
<u>Holena, Miss</u> (mailing address)	<u>clay</u> <u>sand</u>	<u>0</u> <u>12</u>	<u>10</u> <u>45</u>
WELL LOCATION: sec <u>37</u> T. <u>6</u> N R. <u>5</u> E <u>4 1/2</u> miles <u>NE</u> of <u>MAP</u> (distance) (direction) (nearest town)			
WELL PURPOSE: <u>Home</u> (home, irrigation, municipal, industrial)			
WELL COMPLETION DATA:			
(1) diameter (inches) <u>1 1/4</u>			
(2) total depth (feet) <u>45</u>			
(3) static water level (feet) <u>3</u> <u>below</u> above top of ground.			
(4) casing <u>galv</u> (material) (depth)			
(size) if telescope see back.			
(5) screen <u>5</u> <u>40</u> (length) (depth to top)			
<u>1 1/4</u> (size) <u>plastic</u> (material)			
(6) pump (HP) (yield gpm)			
(type power)			
(7) electric log <u>no</u> (yes or no)			
(organization running log)			
(8) how well bottom plugged <u>Bpurbke</u>			
DRILLERS REMARKS: <u> pump installed by owner</u>			

APR 21 1969

MISS. BD. OF  
 WATER COMM.

If well telescopes please sketch and show depths.

GROUND LEVEL

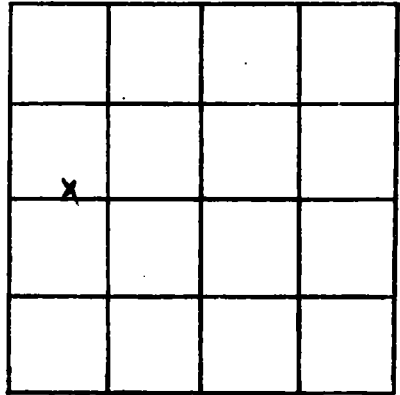

SECTION 32

Please indicate well location X.

ADDITIONAL INFORMATION

A series of horizontal lines for writing additional information, starting below the 'ADDITIONAL INFORMATION' header and extending to the bottom of the page.

If more than one screen, show locations of each on sketch.