

Jackson  
 M112  
 11-14-67

MISSISSIPPI  
 BOARD OF WATER COMMISSIONERS  
 416 North State Street  
 Jackson, Mississippi 39201

CODED

WATER WELL DRILLERS LOG

Nov 14 1967 Colville Water Supply Jackson  
 date well completed firm name county well located

LANDOWNER: Walter Roberts  
Helena Miss  
 (mailing address)

description of formations encountered	from	to
Clay	0	10
sand	10	132
Clay	132	704
sand	704	726

WELL LOCATION:  
 sec. 30 T. 6 N. R. 5 E. W.  
6 miles North of MAP  
 (distance) (direction) (nearest town)

WELL PURPOSE: Home  
 (home, irrigation, municipal, industrial)

CODED

- WELL COMPLETION DATA:
- (1) diameter (inches) 2
  - (2) total depth (feet) 726
  - (3) static water level (feet) 4 below above top of ground.
  - (4) casing galv (material) (depth)  
 (size) If telescope see back.
  - (5) screen 5 921 (length) (depth to top)  
2 (size) galv stainless (material)
  - (6) pump 1/2 7 (HP) (yield gpm)  
elec (type power)
  - (7) electric log no (yes or no)  
 (organization running log)
  - (8) how well bottom plugged BP Valve


DRILLERS REMARKS:

APR 21 1969

MISS. BD. OF  
 WATER COMM.

If well telescopes please sketch and show depths.

GROUND LEVEL

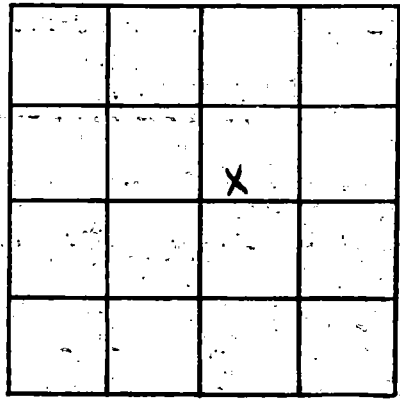

SECTION 30

Please indicate well location X.

ADDITIONAL INFORMATION

If more than one screen, show locations of each on sketch.