

CODED

MISSISSIPPI BOARD OF WATER COMMISSIONERS
416 North State Street
Jackson, Mississippi 39201

WATER WELL DRILLERS LOG

check Jackson

Jackson
M 115
2-69
Feb 1969

Colville Water Sup.

date well completed firm name county well located


LANDOWNER:	description of formations encountered	from	to
Tommy I. James Helena (mailing address)			
WELL LOCATION: sec. 29 T-6 N R-5 E 6 miles North of MMP (distance) (direction) (nearest town)			
WELL PURPOSE: home (home, irrigation, municipal, industrial)			
WELL COMPLETION DATA:			
(1) diameter (inches) 2			
(2) total depth (feet) 271			
(3) static water level (feet) 6 (below above top of ground)			
(4) casing Galv (material) (depth) (size) if telescope see back.			
(5) screen 5 (length) 266 (depth to top) 2 (size) stainless (material)			
(6) pump 3/4 (HP) 8 (yield gpm) elec (type power)			
(7) electric log no (yes or no) (organization running log)			
(8) how well bottom plugged BP Value			
DRILLERS REMARKS:			

JAN - 8 1971

MISS. BD. OF WATER COMMISSIONERS

If well telescopes please sketch and show depths.

GROUND LEVEL

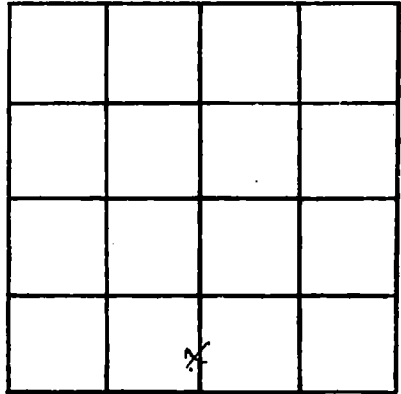

SECTION 29

Please indicate well location X.

ADDITIONAL INFORMATION

If more than one screen, show locations of each on sketch.