

CODED

MISSISSIPPI
BOARD OF WATER COMMISSIONERS
416 North State Street
Jackson, Mississippi 39201

WATER WELL DRILLERS LOG

Jackson
M116
2-17-69

Feb 17 1969 Cothran Water Supply Jackson
date well completed firm name county well located


LANDOWNER: <u>Thomas B. Morgan</u>	description of formations encountered	from	to
<u>Morgan</u>			
<u>Helena Miss</u> (mailing address)	Clay	0	16
WELL LOCATION:	sand	16	64
sec <u>29</u> T <u>6</u> N R <u>5</u> E <u>6</u> miles <u>NE</u> of <u>MP</u> (distance) (direction) (nearest town)	Clay	64	66
WELL PURPOSE: <u>home</u> (home, irrigation, municipal, industrial)	sand	66	110
WELL COMPLETION DATA:			
(1) diameter (inches) <u>2</u>			
(2) total depth (feet) <u>110</u>			
(3) static water level (feet) <u>2</u> <u>below</u> top of ground			
(4) casing <u>galv</u> (material) <u> </u> (depth) <u> </u> (size) if telescope see back.			
(5) screen <u>5</u> (length) <u>105</u> (depth to top)			
<u>2</u> (size) <u>stainless</u> (material)			
(6) pump <u>1/2</u> (HP) <u>6</u> (yield gpm)			
<u> </u> (type power)			
(7) electric log <u>no</u> (yes or no)			
<u> </u> (organization running log)			
(8) how well bottom plugged <u>BP Valve</u>			
DRILLERS REMARKS:			

JAN - 8 1970

MISC. NO. OF
WELL LOG

If well telescopes please sketch and show depths.

GROUND LEVEL

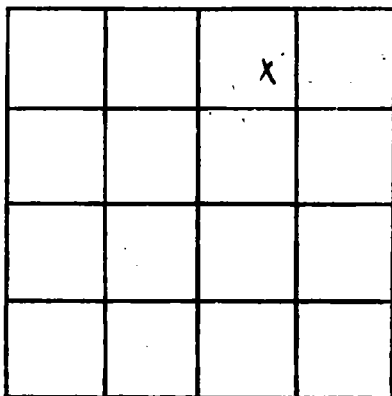

SECTION 29

Please indicate well location X.

ADDITIONAL INFORMATION

Lined area for providing additional information.

If more than one screen, show locations of each on sketch.