

MISSISSIPPI
BOARD OF WATER COMMISSIONERS
416 North State Street
Jackson, Mississippi 39201

WATER WELL DRILLERS LOG

Jackson
M 118
3-1-69

March 1 1969 Cobble Water Supply Jackson
date well completed firm name county well located


LANDOWNER: Frank Everett	description of formations encountered	from	to
Orange Grove (mailing address)	Clay sand Clay sand	0 25 35 44	5 38 44 88
WELL LOCATION: sec. 31 T. 6 N R. 4 E 8 miles West of MP (distance) (direction) (nearest town)	Clay sand	44 89 116	88 116 154
WELL PURPOSE: home (home, irrigation, municipal, industrial)			
WELL COMPLETION DATA: (1) diameter (inches) 2 (2) total depth (feet) 154 (3) static water level (feet) 3 below top of ground. (4) casing galv (material), (depth), (size) If telescope see back. (5) screen 5 (length), 149 (depth to top) 2 (size), slat (material) (6) pump (HP) (yield gpm) (type power) (7) electric log no (yes or no) (organization running log) (8) how well bottom plugged BP valve			
DRILLERS REMARKS: pump installed by owner			

JAN - 8 1970

MISS. BD. OF
WATER COMM.

If well telescopes please sketch and show depths.

GROUND LEVEL

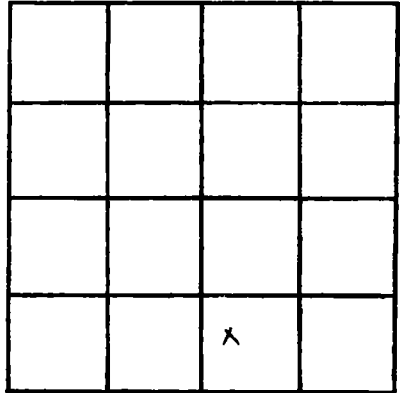

SECTION 31

Please indicate well location X.

ADDITIONAL INFORMATION

A series of horizontal lines for writing additional information.

If more than one screen, show locations of each on sketch.