

CODED

Jackson  
M 119  
6-3-68

MISSISSIPPI  
BOARD OF WATER COMMISSIONERS  
416 North State Street  
Jackson, Mississippi 39201

WATER WELL DRILLERS LOG

June 3 1968 Chickil Water Supply Jackson  
date well completed firm name county well located


LANDOWNER: <u>Bolton</u>	description of formations encountered	from	to
<u>Mission</u>			
<u>Franklin Creek</u> (mailing address)	<u>clay</u>	<u>0</u>	<u>10</u>
	<u>sand</u>	<u>10</u>	<u>44</u>
<b>WELL LOCATION:</b>			
sec. <u>31</u> T <u>6</u> N R <u>5</u> E			
<u>6 1/2</u> miles <u>NE</u> of <u>M.P.</u>			
(distance) (direction) (nearest town)			
<b>WELL PURPOSE:</b> <u>church</u>			
(home, irrigation, municipal, industrial)			
<b>WELL COMPLETION DATA:</b>			
(1) diameter (inches) <u>2</u>			
(2) total depth (feet) <u>44</u>			
(3) static water level (feet) <u>10</u> <sup>below</sup> <sub>above</sub> top of ground			
(4) casing <u>galv</u> (material) (depth)			
(size) If telescope see back.			
(5) screen <u>4</u> (length) <u>40</u> (depth to top)			
<u>2</u> (size) <u>plastic</u> (material)			
(6) pump (HP) (yield gpm)			
(type power)			
(7) electric log <u>no</u> (yes or no)			
(organization running log)			
(8) how well bottom plugged <u>B.P. White</u>			
<b>DRILLERS REMARKS:</b> <u>Installed by owner</u>			

JAN - 8 1970

MISS. STATE  
WATER COMMISSION

If well telescopes please sketch and show depths.

GROUND LEVEL

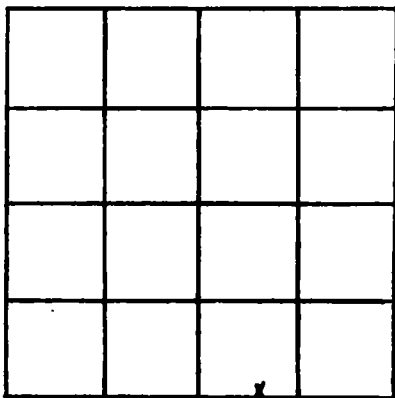

SECTION 31

Please indicate well location X.

ADDITIONAL INFORMATION

If more than one screen,  
show locations of each on sketch.