

**MISSISSIPPI
BOARD OF WATER COMMISSIONERS**
416 North State Street
Jackson, Mississippi 39201

CODED

WATER WELL DRILLERS LOG

Jackson
M 122
8-3-68

August 2 1968 Coahillo Water Supply Jackson
date well completed firm name county well located


LANDOWNER: <u>Bert Fisher</u>	description of formations encountered	from	to
<u>Delena Miss</u> (mailing address)	<u>Old hole</u>		<u>300</u>
WELL LOCATION: sec. <u>28</u> T. <u>6</u> N. R. <u>5</u> E <u>5 1/2</u> miles <u>NE</u> of <u>MP</u> (distance) (direction) (nearest town)	<u>clay</u>	<u>300</u>	<u>676</u>
WELL PURPOSE: <u>home</u> (home, irrigation, municipal, industrial)	<u>fine sand</u>	<u>676</u>	<u>682</u>
WELL COMPLETION DATA: (1) diameter (inches) <u>2</u>	<u>clay</u>	<u>682</u>	<u>836</u>
(2) total depth (feet) <u>912</u>	<u>sand</u>	<u>836</u>	<u>845</u>
(3) static water level (feet) <u>24</u> <u>below</u> top of ground. <u>above</u>	<u>clay</u>	<u>845</u>	<u>849</u>
(4) casing <u>galv</u> (material) (depth) _____ _____ if telescope see back. (size)	<u>sand</u>	<u>849</u>	<u>912</u>
(5) screen <u>15'</u> (length) <u>897</u> (depth to top)			
_____ (size) <u>2"</u> (material) <u>stainless</u>			
(6) pump <u>no pump</u> (HP) (yield/gpm)			
(7) electric log <u>no</u> (yes or no)			
(8) how well bottom plugged <u>BPI/ky</u>			
DRILLERS REMARKS:			

JAN - 8 1970

MISS. BD. OF
WATER COMM.

If well telescopes please sketch and show depths.

GROUND LEVEL

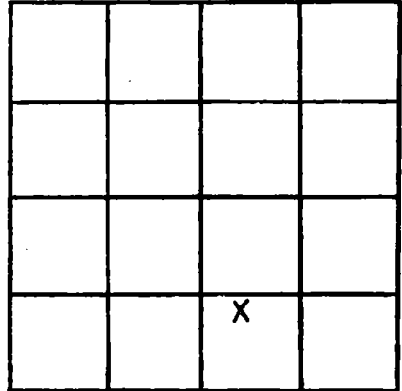

SECTION 28

Please indicate well location X.

ADDITIONAL INFORMATION

If more than one screen,
show locations of each on sketch.