

CODED

Jackson
M123
8-16-68

MISSISSIPPI
BOARD OF WATER COMMISSIONERS
416 North State Street
Jackson, Mississippi 39201

WATER WELL DRILLERS LOG

Aug. 16 1968 Cabille Water Sys. Jackson
date well completed firm name county well located


LANDOWNER: Kenneth Song	description of formations encountered	from	to
Helena Minn (mailing address)	clay	0	22
WELL LOCATION: sec. 26 T 6 N R 5 E 6 miles NE of MP (distance) (direction) (nearest town)	sand	22	58
WELL PURPOSE: home (home, irrigation, municipal, industrial)	clay	88	110
WELL COMPLETION DATA: (1) diameter (inches) 2	sand	110	169
(2) total depth (feet) 215	clay	169	190
(3) static water level (feet) 19 below top of ground	sand	190	215
(4) casing galv (material), (depth)			
(5) screen 4 (length), 211 (depth to top)			
(6) pump (HP) (yield gpm)			
(7) electric log no (yes or no)			
(8) how well bottom plugged BPUdry			
DRILLERS REMARKS: pump installed by owner			

JAN - 8 1970

MISS. DIV. OF
WATER COMM.

If well telescopes please sketch and show depths.

GROUND LEVEL

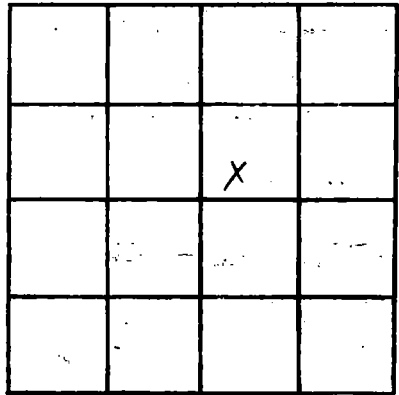

SECTION 26

Please indicate well location X.

ADDITIONAL INFORMATION

If more than one screen, show locations of each on sketch.