

CODED

Jackson  
M124  
8-22-68

MISSISSIPPI  
BOARD OF WATER COMMISSIONERS  
416 North State Street  
Jackson, Mississippi 39201

WATER WELL DRILLERS LOG

Aug 22 1968 Lebanon Water Sup Jackson  
Date well completed firm name county well located


LANDOWNER: <u>Leron</u>	description of formations encountered	from	to
<u>Pierce</u>			
<u>Helena Mine</u> (mailing address)	<u>Clay</u>	<u>0</u>	<u>66</u>
WELL LOCATION:	<u>sand</u>	<u>66</u>	<u>125</u>
sec. <u>8</u> T. <u>6</u> N. R. <u>2</u> E	<u>Clay</u>	<u>125</u>	<u>154</u>
<u>3 1/2</u> miles <u>S</u> of <u>Rio Point</u>	<u>sand</u>	<u>154</u>	<u>210</u>
(distance) (direction) (nearest town)	<u>clay</u>	<u>210</u>	<u>253</u>
WELL PURPOSE: <u>home</u>			
(home, irrigation, municipal, industrial)			
WELL COMPLETION DATA:			
(1) diameter (inches) <u>2</u>			
(2) total depth (feet) <u>286</u>			
(3) static water level (feet) <u>5-7</u> <sup>below</sup> above top of ground			
(4) casing <u>galv</u> (material) _____ (depth) _____			
_____ (size) if telescope see back.			
(5) screen <u>4'</u> (length) <u>282</u> (depth to top)			
<u>2</u> (size) <u>stainless</u> (material)			
(6) pump _____ (HP) _____ (yield gpm)			
_____ (type power)			
(7) electric log <u>no</u> (yes or no)			
_____ (organization running log)			
(8) how well bottom plugged <u>BP/dep</u>			
DRILLERS REMARKS: <u>pump installed by owner</u>			

JAN - 8 1970

MISC. BD. OF  
WATER COMM.

If well telescopes please sketch and show depths.

GROUND LEVEL

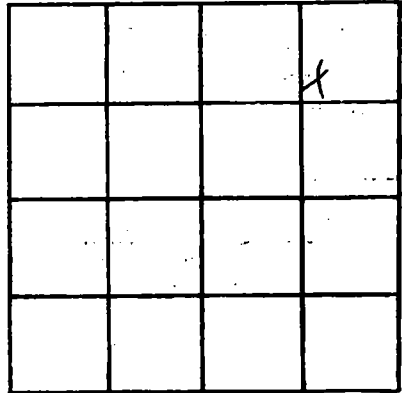

SECTION 8

Please indicate well location X.

ADDITIONAL INFORMATION

If more than one screen, show locations of each on sketch.