

CODED

MISSISSIPPI  
BOARD OF WATER COMMISSIONERS  
416 North State Street  
Jackson, Mississippi 39201

WATER WELL DRILLERS LOG

Jackson  
M126  
10-21-68

Oct 21 1968 BB Cahill Water Supply Jackson  
date well completed firm name county well located

LANDOWNER: Ray F. Krebs #1 Fort Lake  
(mailing address)

description of formations encountered	from	to
<u>sandy strata</u>	<u>0</u>	<u>22</u>
<u>loam</u>	<u>22</u>	<u>50</u>
<u>clay</u>	<u>50</u>	<u>86</u>
<u>sand</u>	<u>86</u>	<u>115</u>

WELL LOCATION:  
sec. 17 T. 6 N. R. 4 E.  
12 miles NW of MP  
(distance) (direction) (nearest town)

WELL PURPOSE: home  
(home, irrigation, municipal, industrial)

- WELL COMPLETION DATA:
- (1) diameter (inches) 2
  - (2) total depth (feet) 120
  - (3) static water level (feet) 33'-6" <sup>below</sup> <sub>above</sub> top of ground.
  - (4) casing galv 115  
(material) (depth)  
(size) if telescope see back.
  - (5) screen 5 115  
(length) (depth to top)  
2 stainless  
(size) (material)
  - (6) pump \_\_\_\_\_  
(HP) (yield gpm)  
(type power)
  - (7) electric log no  
(yes or no)  
(organization running log)
  - (8) how well bottom plugged BP Value


JAN - 8 1970

MISS. BB. OF  
WATER COMM.

DRILLERS REMARKS: Pump installed by owner

If well telescopes please sketch and show depths.

GROUND LEVEL

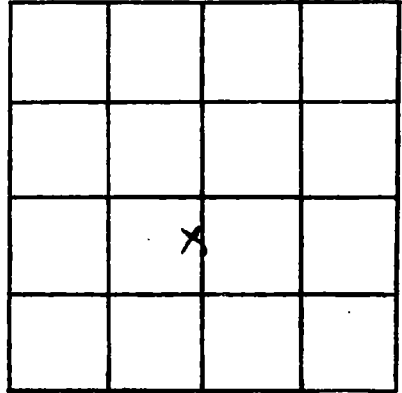

SECTION 17

Please indicate well location X.

ADDITIONAL INFORMATION

Lined area for additional information.

If more than one screen, show locations of each on sketch.