

Jackson
M 127
10-23-68

MISSISSIPPI
BOARD OF WATER COMMISSIONERS
416 North State Street
Jackson, Mississippi 39201

CODED

WATER WELL DRILLERS LOG

Oct 23 1968 Cobille Water Supply Jackson
date well completed firm name County well located


LANDOWNER: Bay F	description of formations encountered	from	to
Bochs # 2	steady druck	0	22
Forts Lake (mailing address)	sand	22	50
WELL LOCATION:	clay	50	96
sec. 17 T. 6 N. R. 4 E	sand	96	115
12 miles NE of MP (distance) (direction) (nearest town)			
WELL PURPOSE: home (home, irrigation, municipal, industrial)			
WELL COMPLETION DATA:			
(1) diameter (inches) 2			
(2) total depth (feet) 120			
(3) static water level (feet) 33-6' below top of ground. above			
(4) casing galv. 115' (material) (depth)			
<u>2</u> (size) if telescope see back.			
(5) screen 5' 115' (length) (depth to top)			
<u>2</u> stainless (size) (material)			
(6) pump (HP) (yield gpm)			
(type power)			
(7) electric log no (yes or no)			
(organization running log)			
(8) how well bottom plugged BPO plus			
DRILLERS REMARKS: pump installed by owner			

JAN - 8 1970

MISS. BD. OF
WATER COM. 2

If well telescopes please sketch and show depths.

GROUND LEVEL

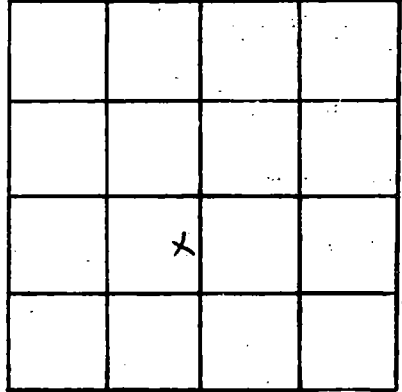

SECTION 17

Please indicate well location X.

ADDITIONAL INFORMATION

If more than one screen, show locations of each on sketch.