

Jackson
M 129
12-1-69

MISSISSIPPI
 BOARD OF WATER COMMISSIONERS
 416 North State Street
 Jackson, Mississippi 39201

CODED


WATER WELL DRILLERS LOG

Dec 1 1969 Colville Water Supply Jackson
 date well completed firm name county well located

LANDOWNER: <u>Deasil H Harrison</u>	description of formations encountered	from	to
<u>Helena</u> (mailing address)	<u>Clay</u>	<u>0</u>	<u>5</u>
WELL LOCATION: sec <u>31</u> T <u>6</u> N R <u>5</u> E <u>5</u> miles <u>North</u> of <u>MAP</u> (distance) (direction) (nearest town)	<u>sand</u>	<u>5</u>	<u>73</u>
WELL PURPOSE: <u>Home</u> (home, irrigation, municipal, industrial)	<u>Clay</u>	<u>73</u>	<u>231</u>
WELL COMPLETION DATA: (1) diameter (inches) <u>2</u> (2) total depth (feet) <u>253</u> (3) static water level (feet) <u>21</u> <u>below</u> above top of ground. (4) casing <u>galv</u> (material), (depth) _____ (size) if telescope see back. (5) screen <u>10</u> (length), <u>243</u> (depth to top) (size) (material) <u>2</u> (size) <u>standard</u> (material) (6) pump <u>3/4</u> (HP), <u>7</u> (yield gpm) (type power) (7) electric log <u>no</u> (yes or no) (organization running log) _____ (8) how well bottom plugged <u>BP Valve</u>	<u>sand</u>	<u>231</u>	<u>253</u>
DRILLERS REMARKS:	JAN - 8 1970	MISS. BD. OF	WATER COM.

If well telescopes please sketch and show depths.

GROUND LEVEL

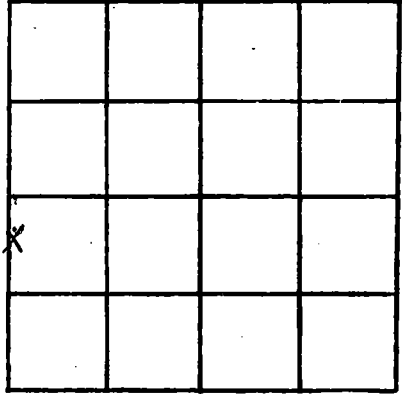

SECTION 31

Please indicate well location X.

ADDITIONAL INFORMATION

*sand extremely fine -
gravel packed*

If more than one screen,
show locations of each on sketch.