

Jackson
 M 130
 12-20-68

MISSISSIPPI
 BOARD OF WATER COMMISSIONERS
 416 North State Street
 Jackson, Mississippi 39201

CODED

WATER WELL DRILLERS LOG

Dec 20 1968 Calville Water Supply Jackson
 date well completed firm name county well located


LANDOWNER: <u>Vernon</u>	description of formations encountered	from	to
<u>Stork</u>	<u>Sand</u>	<u>0</u>	<u>166</u>
<u>Forts Lake</u> (mailing address)	<u>Sand and clay streak</u>	<u>66</u>	<u>58</u>
WELL LOCATION: sec. <u>17</u> T. <u>6</u> N R. <u>4</u> E <u>13</u> miles <u>NE</u> of <u>M.P.</u> (distance) (direction) (nearest town)			
WELL PURPOSE: <u>home</u> (home, irrigation, municipal, industrial)			
WELL COMPLETION DATA: (1) diameter (inches) <u>2</u> (2) total depth (feet) <u>109</u> (3) static water level (feet) <u>32</u> <u>below</u> top of ground. (4) casing <u>Galv</u> (material), (depth) _____ _____ (size) if telescope see back. (5) screen <u>4</u> (length), <u>105</u> (depth to top) <u>2</u> (size), <u>plastic</u> (material) (6) pump _____ (HP) _____ (yield gpm) _____ (type power) (7) electric log <u>no</u> (yes or no) _____ (organization running log) (8) how well bottom plugged <u>By Vally</u>			
DRILLERS REMARKS: <u>pump installed by owner</u>			

JAN 8 1970

MISS. BD. OF
 WATER COMMISSIONERS

If well telescopes please sketch and show depths.

GROUND LEVEL

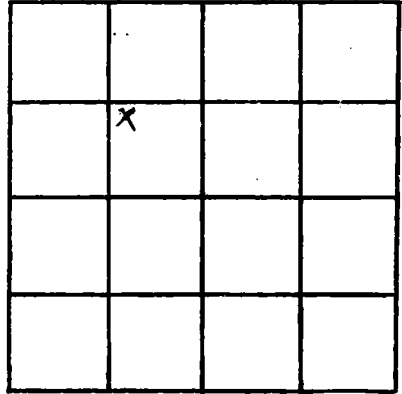

SECTION 17

Please indicate well location X.

ADDITIONAL INFORMATION

If more than one screen,
show locations of each on sketch.