

CODED

MISSISSIPPI
BOARD OF WATER COMMISSIONERS
416 North State Street
Jackson, Mississippi 39201

WATER WELL DRILLERS LOG

Jackson
M 132
12-27-68

Dec 27 1968 Osborne Water Supply Jackson
date well completed firm name county well located


LANDOWNER: <u>Ellis Smith</u>	description of formations encountered	from	to
<u>Forts Lake</u> (mailing address)	<u>sand</u>	<u>0</u>	<u>55</u>
	<u>clay</u>	<u>55</u>	<u>70</u>
	<u>sand</u>	<u>70</u>	<u>112</u>
	<u>clay</u>	<u>112</u>	<u>190</u>
	<u>sand</u>	<u>190</u>	<u>190</u>
WELL LOCATION:			
sec. <u>17</u> T. <u>6</u> N. R. <u>4</u> E <u>13</u> miles <u>NE</u> of <u>MP</u> (distance) (direction) (nearest town)			
WELL PURPOSE: <u>home</u> (home, irrigation, municipal, industrial)			
WELL COMPLETION DATA:			
(1) diameter (inches) <u>2</u>			
(2) total depth (feet) <u>190</u>			
(3) static water level (feet) <u>27</u> ^(below) above top of ground			
(4) casing <u>galv</u> (material) (depth)			
_____ if telescope see back. (size)			
(5) screen <u>4'</u> <u>186</u> (length) (depth to top)			
_____ (size) <u>stainless</u> (material)			
(6) pump <u>1/2</u> <u>5</u> (HP) (yield gpm)			
_____ (type power)			
(7) electric log <u>no</u> (yes or no)			
_____ (organization running log)			
(8) how well bottom plugged <u>B.P. Valley</u>			
DRILLERS REMARKS:			

JAN - 8 1970

MISS. BD. OF
WATER COM.

If well telescopes please sketch and show depths.

GROUND LEVEL

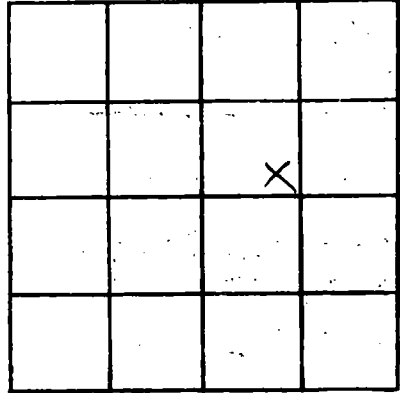

SECTION 17

Please indicate well location X.

ADDITIONAL INFORMATION

If more than one screen, show locations of each on sketch.