

Jackson
 M 134
 5-6-70

MISSISSIPPI
 BOARD OF WATER COMMISSIONERS
 416 North State Street
 Jackson, Mississippi 39201

CODED

WATER WELL DRILLERS LOG

May 16 1970 date well completed
 Colville Water Supply firm name
 Jackson county well located


LANDOWNER: <u>Charles</u>	description of formations encountered	from	to
<u>W. Mays</u>	<u>sandy clay</u>	<u>0</u>	<u>10</u>
<u>Big Point Mass</u> (mailing address)	<u>sand</u>	<u>10</u>	<u>130</u>
WELL LOCATION: sec. <u>8</u> T. <u>6</u> N. R. <u>5</u> E. <u>006</u>	<u>clay</u>	<u>130</u>	<u>162</u>
<u>11</u> miles <u>North</u> of <u>MP</u> (distance) (direction) (nearest town)	<u>sand</u>	<u>162</u>	<u>216</u>
WELL PURPOSE: (home, irrigation, municipal, industrial)			
WELL COMPLETION DATA:			
(1) diameter (inches) <u>2</u>			
(2) total depth (feet) <u>216</u>			
(3) static water level (feet) <u>12</u> <u>below</u> above top of ground.			
(4) casing <u>galv</u> (material) (depth)			
(size) if telescope see back.			
(5) screen <u>10'</u> <u>206</u> (length) (depth to top)			
<u>2</u> <u>stainless</u> (size) (material)			
(6) pump <u>1/2</u> <u>7</u> (HP) (yield gpm)			
<u>elec</u> (type power)			
(7) electric log <u>no</u> (yes or no)			
(organization running log)			
(8) how well bottom plugged <u>BP Valve</u>			
DRILLERS REMARKS:			

MAY 20 1970

MISSISSIPPI
 WATER

If well telescopes please sketch and show depths.

GROUND LEVEL

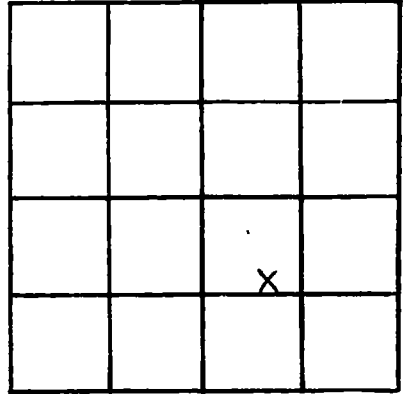

SECTION 8

Please indicate well location X.

ADDITIONAL INFORMATION

If more than one screen, show locations of each on sketch.