

JACKSON

M 138

8-18-70

MISSISSIPPI  
BOARD OF WATER COMMISSIONERS  
416 North State Street  
Jackson, Mississippi 39201

**CODED**

WATER WELL DRILLERS LOG

Aug 18

1970

Cohille Water Supply

Jackson

date well completed

firm name

county well located

LANDOWNER: Robert M. McMan

and Jack Whittington  
Gunn Landing  
(mailing address)

description of formations encountered

from

to

sandy clay	0	10
sand	10	36
blue clay	36	47
gravel	47	120
clay	120	236
shale	236	269
clay	269	331
sand	331	357
clay shells	357	362
gray clay and fine sand	362	472
shale	472	484
clay	484	544
sand	544	562

WELL LOCATION:

sec. 2 T. 6 N. R. 5 E  
10 1/2 miles NE of M.P.  
(distance) (direction) (nearest town)

WELL PURPOSE: home  
(home, irrigation, municipal, industrial)

WELL COMPLETION DATA:

- (1) diameter (inches) 2
- (2) total depth (feet) 562
- (3) static water level (feet) 15-10 <sup>below</sup>/<sub>above</sub> top of ground.
- (4) casing galv 557  
(material) (depth)  
(size) If telescope see back.
- (5) screen 5' 557  
(length) (depth to top)  
2" Stainless  
(size) (material)
- (6) pump None  
(HP) (yield gpm)  
(type power)
- (7) electric log no  
(yes or no)  
(organization running log)
- (8) how well bottom plugged BD Valve

**CODED**


SEP 11 1970

DRILLERS REMARKS:

MISS. BD. OF  
WATER COMM.

If well telescopes please sketch and show depths.

GROUND LEVEL

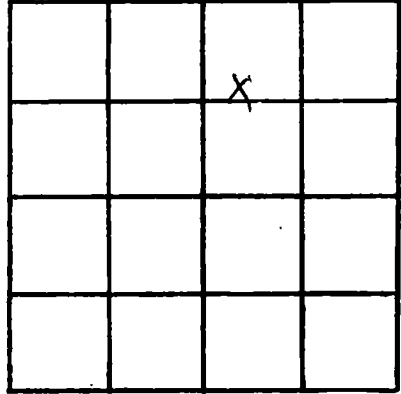

SECTION 2

Please indicate well location X.

ADDITIONAL INFORMATION

If more than one screen, show locations of each on sketch.