

JACKSON
M139
7-3-70

MISSISSIPPI
BOARD OF WATER COMMISSIONERS
416 North State Street
Jackson, Mississippi 39201

CODED

WATER WELL DRILLERS LOG

7-3 1970 20 cent White Well Service Jackson
date well completed firm name county well located

LANDOWNER: Pat Jackson
424 Len Lake Blvd.
Miss Point, Miss.
(mailing address)

description of formations encountered	from	to
<u>Surface Soil</u>	<u>0</u>	<u>18</u>
<u>Sand-mud to coarse</u>	<u>18</u>	<u>42</u>
<u>Blue clay</u>	<u>42</u>	<u>170</u>
<u>Sand-mud to coarse</u>	<u>170</u>	<u>220</u>

WELL LOCATION:
sec. 21 T. 6 N. R. 4 E.
S. W.
10 miles NE of Miss Point
(distance) (direction) (nearest town)

WELL PURPOSE: Flonice
(home, irrigation, municipal, industrial)

WELL COMPLETION DATA:

(1) diameter (inches) 2"

(2) total depth (feet) 220'

(3) static water level (feet) 12 below above top of ground.

(4) casing Galv. 210'
(material) (depth)
2" If telescope see back.
(size)

(5) screen 10' 210'
(length) (depth to top)
2" Stainless Steel
(size) (material)

(6) pump 1 12
(HP) (yield gpm)
Elec.
(type power)

(7) electric log NO
(yes or no)
(organization running log)

CODED

SEP 18 1970

(8) how well bottom plugged
Backwash Valve


MISS. BD. OF
WATER COMM.

DRILLERS REMARKS:

If well telescopes please sketch and show depths.

5207

GROUND LEVEL

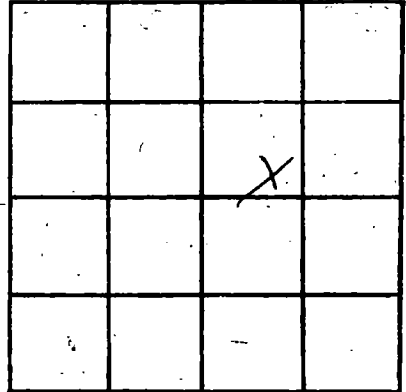

SECTION 31

Please indicate well location X.

ADDITIONAL INFORMATION

If more than one screen,
show locations of each on sketch.