

JACKSON
M 141
7-8-70

MISSISSIPPI
BOARD OF WATER COMMISSIONERS
416 North State Street
Jackson, Mississippi 39201

CODED

WATER WELL DRILLERS LOG

July 8 1970 date well completed
Cobille Water Supply firm name
Jackson county well located

LANDOWNER: J.L. Alexander
Helena, Miss (mailing address)
WELL LOCATION:
sec. 29 T. 6 N. R. 5 E
7 miles North of M.P.
(distance) (direction) (nearest town)

description of formations encountered	from	to
pep. clay	0	21
sand	21	28
clay	28	110
sand	110	136
clay	136	231
sand	231	278

WELL PURPOSE: home
(home, irrigation, municipal, industrial)

WELL COMPLETION DATA:
(1) diameter (inches) 3
(2) total depth (feet) 278
(3) static water level (feet) 12 below top of ground
(4) casing galv. 273 (material) (depth)
(size) if telescope see back.
(5) screen 5' 273 (length) (depth to top)
2" stainless (size) (material)
(6) pump (HP) (yield gpm)
(type power)
(7) electric log no (yes or no)
(organization running log)
(8) how well bottom plugged BP Valve

CODED


AUG 17 1970

DRILLERS REMARKS: pump installed by owner

MISS. BD. OF
WATER COMM.

If well telescopes please sketch and show depths.

GROUND LEVEL

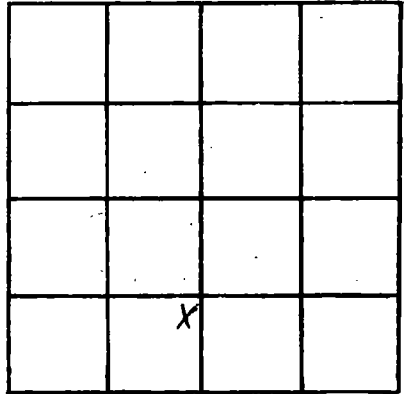

SECTION 29

Please indicate well location X.

ADDITIONAL INFORMATION

If more than one screen, show locations of each on sketch.