

JACKSON
M 142
9-10-70

MISSISSIPPI
BOARD OF WATER COMMISSIONERS
416 North State Street
Jackson, Mississippi 39201

CODED

WATER WELL DRILLERS LOG

Sept 10 1970 data well completed
Cobville Water Supply firm name
Jackson county well located

LANDOWNER: <u>Kenneth Overby</u>	description of formations encountered	from	to
<u>Melvin Minor</u> (mailing address)	<u>clay</u>	<u>0</u>	<u>18</u>
WELL LOCATION: sec. <u>34</u> T- <u>6</u> N R- <u>5</u> E <u>6</u> miles <u>NE</u> of <u>MP</u> (distance) (direction) (nearest town)	<u>sand</u>	<u>18</u>	<u>55</u>
WELL PURPOSE: <u>house</u> (home, irrigation, municipal, industrial)	<u>clay</u>	<u>55</u>	<u>116</u>
WELL COMPLETION DATA:	<u>sand</u>	<u>116</u>	<u>152</u>
(1) diameter (inches) <u>2</u>	CODED		
(2) total depth (feet) <u>152</u>			
(3) static water level (feet) <u>246</u> ^{below} <u>above</u> top of ground.			
(4) casing <u>galv</u> , <u>147</u> , (material) (depth)			
(size) If telescope see back.			
(5) screen <u>5</u> , <u>147</u> (length) (depth to top)			
<u>2</u> , <u>stainless</u> (size) (material)			
(6) pump <u>1/2</u> , <u>8</u> (HP) (yield gpm)			
<u>elec</u> (type power)			
(7) electric log <u>no</u> (yes or no)			
(organization running log)			
(8) how well bottom plugged <u>BPO value</u>			

CODED


OCT 14 1970

MISS. BD. OF
WATER COM.

DRILLERS REMARKS:

If well telescopes please sketch and show depths.

GROUND LEVEL

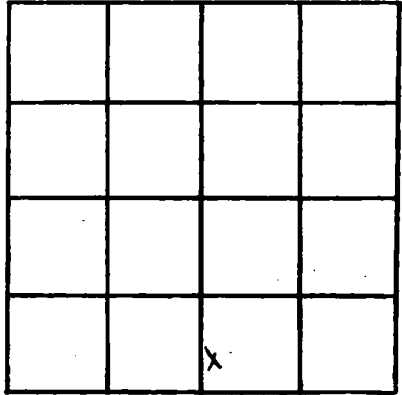

SECTION 34

Please indicate well location X.

ADDITIONAL INFORMATION

If more than one screen, show locations of each on sketch.