

JACKSON

M143

9-25-70

MISSISSIPPI BOARD OF WATER COMMISSIONERS  
416 North State Street  
Jackson, Mississippi 39201

**CODED**

WATER WELL DRILLERS LOG

Sept 25 1970 data well completed  
Mobile Water Supply Jackson firm name  
County well located

LANDOWNER: V.W.

Rawles

description of formations encountered

from to

Adena Miss  
(mailing address)

Clay 0 14  
Sand 14 63  
off clay 63 81  
sand 81 91

WELL LOCATION:

sec 33 T-6 N R-5 E  
6 miles NE of MP  
(distance) (direction) (nearest town)

WELL PURPOSE: home  
(home, irrigation, municipal, industrial)

WELL COMPLETION DATA:

- (1) diameter (inches) 2
- (2) total depth (feet) 91
- (3) static water level (feet) 10 <sup>below</sup> above top of ground.
- (4) casing plastic, 86  
(material) (depth)

**CODED**

(size) If telescope see back.

- (5) screen 5' 86  
(length) (depth to top)
- 2 plastic  
(size) (material)

- (6) pump (HP) (yield gpm)

(type power)

- (7) electric log no  
(yes or no)

(organization running log)

- (8) how well bottom plugged BPC value

OCT 14 1970


MISS. BD. OF WATER COMM.

DRILLERS REMARKS:

pump installed by owner

If well telescopes please sketch and show depths.

GROUND LEVEL

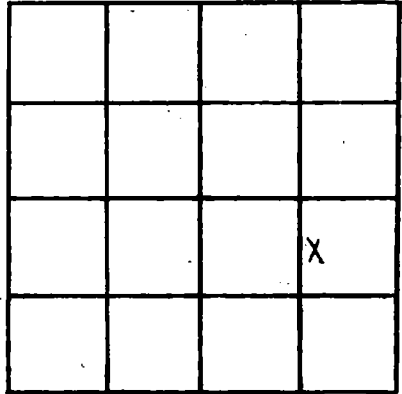

SECTION 33

Please indicate well location X.

ADDITIONAL INFORMATION

If more than one screen, show locations of each on sketch.