

JACKSON
M144
9-27-70

MISSISSIPPI
BOARD OF WATER COMMISSIONER
416 North State Street
Jackson, Mississippi 39201

CODED

WATER WELL DRILLERS LOG

Sept 27 1970 Calhoun Water Supply Jackson
date well completed firm name county well located

LANDOWNER: <u>William</u>	description of formations encountered	from	to
<u>Hester</u>			
<u>Helena, Miss</u> (mailing address)	<u>sandy clay</u> <u>sand</u>	<u>0</u> <u>44</u>	<u>44</u> <u>57</u>
WELL LOCATION:			
sec. <u>34</u> T- <u>6</u> N R- <u>5</u> E <u>6</u> miles <u>NE</u> of <u>MP</u> (distance) (direction) (nearest town)			
WELL PURPOSE: <u>home</u> (home, irrigation, municipal, industrial)			
WELL COMPLETION DATA:			
(1) diameter (inches) <u>2</u>			
(2) total depth (feet) <u>57</u>			
(3) static water level (feet) <u>7-6</u> <u>below</u> above top of ground.			
(4) casing <u>plastic</u> , <u>57</u> (material) (depth)			
(size) if telescope see back.			
(5) screen <u>4'</u> , <u>53</u> (length) (depth to top)			
<u>2</u> <u>plastic</u> (size) (material)			
(6) pump _____ (HP) _____ (yield gpm)			
(type power)			
(7) electric log <u>no</u> (yes or no)			
(organization running log)			
(8) how well bottom plugged <u>B.P. Value</u>			
DRILLERS REMARKS: <u>pump installed by owner</u>			


CODED

OCT 14 1970

MISS. BD. OF
WATER COMM.

If well telescopes please sketch and show depths.

GROUND LEVEL

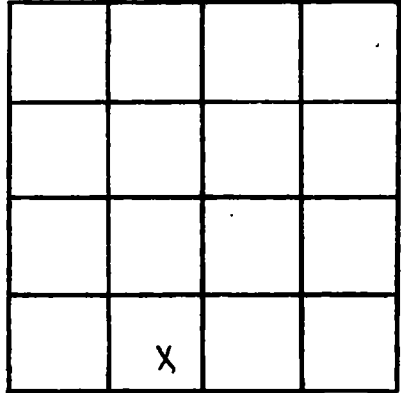

SECTION 34

Please indicate well location X.

ADDITIONAL INFORMATION

If more than one screen, show locations of each on sketch.