

JACKSON  
M 145  
9-29-70

MISSISSIPPI  
BOARD OF WATER COMMISSIONERS  
416 North State Street  
Jackson, Mississippi 39201

**CODED**

WATER WELL DRILLERS LOG

Sept 29 1970 Colerick Water Supply Jackson  
date well completed firm name county well located

LANDOWNER: C. J. May  
Helena, Miss.  
(mailing address)

description of formations encountered	from	to
clay	0	47
sand	47	105
clay	105	132
sand	132	155

WELL LOCATION:  
sec. 11 T. 6 N. R. 5 E.  
10 miles NE of MP  
(distance) (direction) (nearest town)

WELL PURPOSE: Home  
(home, irrigation, municipal, industrial)

- WELL COMPLETION DATA:
- (1) diameter (inches) 2
  - (2) total depth (feet) 155
  - (3) static water level (feet) 7-9 <sup>below</sup> above top of ground.
  - (4) casing galv. 150  
(material) (depth)  
(size) If telescope see back.
  - (5) screen 5 150  
(length) (depth to top)  
2 stainless  
(size) (material)
  - (6) pump \_\_\_\_\_  
(HP) (yield gpm)  
(type power)
  - (7) electric log no  
(yes or no)  
(organization running log)
  - (8) how well bottom plugged \_\_\_\_\_

**CODED**


OCT 14 1970

MISS. BD. OF  
WATER COMM.

DRILLERS REMARKS:

If well telescopes please sketch and show depths.

GROUND LEVEL

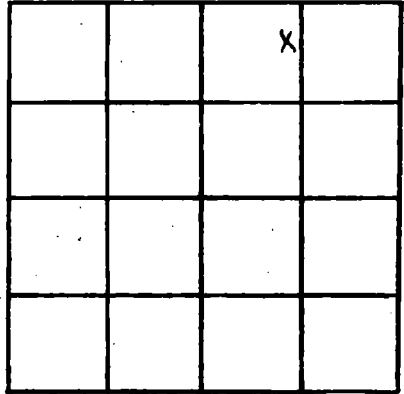

SECTION 11

Please indicate well location X.

ADDITIONAL INFORMATION

If more than one screen, show locations of each on sketch.