

JACKSON
M147
10-9-70

MISSISSIPPI
BOARD OF WATER COMMISSIONERS
416 North State Street
Jackson, Mississippi 39201

CODED

WATER WELL DRILLERS LOG

Oct 9 1970 data well completed
Coballe Water Supply firm name
Jackson county well located


LANDOWNER: <u>Robert</u>	description of formations encountered	from	to
<u>Barrison</u>	<u>sand</u>	0	40
<u>Helena, Miss</u> (mailing address)	<u>clay</u>	40	48
WELL LOCATION: sec. <u>11</u> T. <u>6</u> N. R. <u>5</u> E. <u>10</u> miles <u>NK</u> of <u>MP</u> (distance) (direction) (nearest town)	<u>sand</u>	48	130
WELL PURPOSE: <u>home</u> (home, irrigation, municipal, industrial)	<u>clay</u>	130	140
WELL COMPLETION DATA:	<u>sand</u>	140	153
(1) diameter (inches) <u>2</u>	CODED		
(2) total depth (feet) <u>153</u>			
(3) static water level (feet) <u>9.2</u> ^{below} above top of ground.			
(4) casing <u>galv</u> , <u>148</u> , (material) (depth)			
(size) If telescope see back.			
(5) screen <u>5</u> , <u>148</u> (length) (depth to top)			
<u>2</u> , <u>stainless</u> (size) (material)			
(6) pump _____ (HP) (yield gpm)			
(type power)			
(7) electric log <u>no</u> (yes or no)			
(organization running log)			
(8) how well bottom plugged <u>BPO valve</u>			
DRILLERS REMARKS:			

OCT 14 1970

MISS. BD. OF
WATER COMM.

If well telescopes please sketch and show depths.

GROUND LEVEL

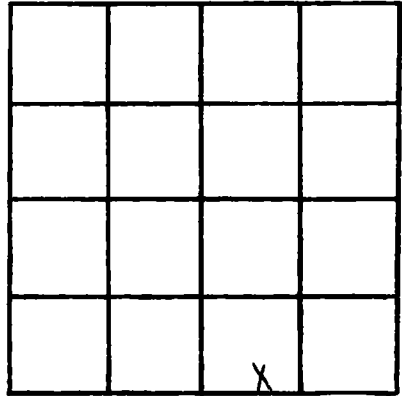

SECTION _____

Please indicate well location X.

ADDITIONAL INFORMATION

If more than one screen, show locations of each on sketch.