

JACKSON
M148
10-10-70

MISSISSIPPI
BOARD OF WATER COMMISSIONERS
416 North State Street
Jackson, Mississippi 39201

CODED

WATER WELL DRILLERS LOG

Oct 10 1970 Columbia Water Supply Jackson
date well completed firm name county well located

LANDOWNER:	description of formations encountered	from	to
<u>S.M. Mathews</u>			
<u>Helen M. Min</u> (mailing address)	<u>gravel</u>	<u>27</u>	<u>35</u>
	<u>clay</u>	<u>35</u>	<u>83</u>
	<u>sand</u>	<u>83</u>	<u>131</u>
	<u>clay</u>	<u>131</u>	<u>208</u>
	<u>sand</u>	<u>208</u>	<u>226</u>

WELL LOCATION:
sec. 28 E T. 6 N R. 5 E W. 1
8 miles NE of MP
(distance) (direction) (nearest town)

WELL PURPOSE: home
(home, irrigation, municipal, industrial)

- WELL COMPLETION DATA:
- (1) diameter (inches) 2
 - (2) total depth (feet) 226
 - (3) static water level (feet) 3 below above top of ground.
 - (4) casing galv., 221,
(material) (depth)
2 if telescope see back.
(size)
 - (5) screen 5', 221
(length) (depth to top)
2, stainless
(size) (material)
 - (6) pump _____ (HP) _____ (yield gpm)
(type power)
 - (7) electric log no
(yes or no)
(organization running log)
 - (8) how well bottom plugged BP Valve

CODED


OCT 14 1970

DRILLERS REMARKS: pump installed by owner

MISS. BD. OF
WATER COMM.

If well telescopes please sketch and show depths.

GROUND LEVEL

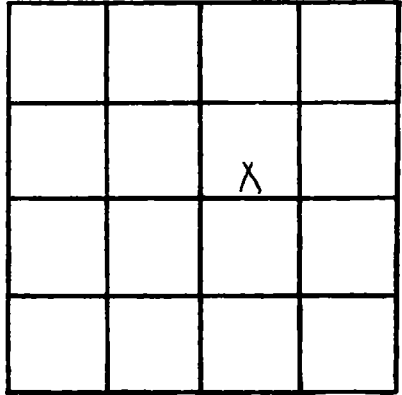

SECTION 28

Please indicate well location X.

ADDITIONAL INFORMATION

If more than one screen,
show locations of each on sketch.