

FEB 16 1971

JACKSON
M 150
1-2-71

MISSISSIPPI
BOARD OF WATER COMMISSIONERS
416 North State Street
Jackson, Mississippi 39201

MISS. BD. OF
WATER COMM.

CODED

WATER WELL DRILLERS LOG

Jan 2 1971 Colville Water Supply Jackson
date well completed firm name county well located

LANDOWNER: F. Walker
(Fletcher)
Helena Min
(mailing address)

description of formations encountered	from	to
clay	0	45
sand	45	80
clay	80	169
sand	169	195

WELL LOCATION:
sec. 11 T. 6 N. R. 5 E.
10 miles NE of MP
(distance) (direction) (nearest town)

WELL PURPOSE: house
(home, irrigation, municipal, industrial)

WELL COMPLETION DATA:

(1) diameter (inches) 2

(2) total depth (feet) 195

(3) static water level (feet) 10 ^{below} _{above} top of ground.

(4) casing galv 195
(material) (depth)

(size) If telescope see back.

(5) screen 5 190
(length) (depth to top)

2 stainless
(size) (material)

(6) pump 1/2 10
(HP) (yield gpm)

elec
(type power)

(7) electric log no
(yes or no)

(organization running log)


(8) how well bottom plugged B.P. Walker

CODED

DRILLERS REMARKS:

If well telescopes please sketch and show depths.

GROUND LEVEL

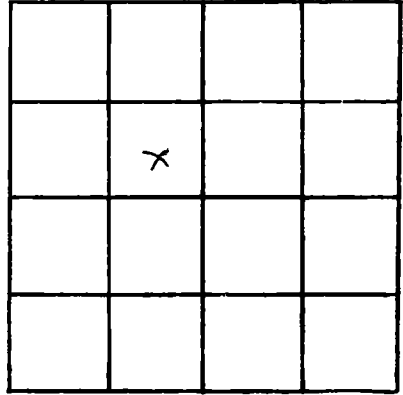

SECTION 11

Please indicate well location X.

ADDITIONAL INFORMATION

If more than one screen,
show locations of each on sketch.