

JACKSON MISSISSIPPI BOARD OF WATER COMMISSIONERS

M 153 *Can't locate*

WATER WELL DRILLERS LOG

CODED

11-10-61

3337

Date: Nov 10, 1961, Driller: Colville

County JACKSON

(Name)

(1) Owner of Land: CE. VICE
 (Name)
Helena
 (Address)

(2) Location: 1/4, 1/4, Sec. 32 T 6 R 5
6 miles Northeast, of Escatawpa
 (distance) (direction) (Nearest Town)

(3) Topography: Flat
 (Hilly) (Flat) (Level)

(4) Purpose of Well: DOMESTIC
 (Domestic Irrigation
 Municipal, Industrial, Other)

Description & Color of Materials Sand, Clay, Red Clay, Shell, etc.	Thick- ness Feet	Depth Feet
<u>Yellow Clay</u>		<u>8</u>
<u>Sand</u>	<u>58</u>	<u>66</u>
<u>Clay</u>	<u>54</u>	<u>120</u>
<u>Sand</u>	<u>6</u>	<u>126</u>
<u>Clay</u>	<u>104</u>	<u>230</u>
<u>Sand</u>	<u>3</u>	<u>233</u>
<u>Clay</u>	<u>198</u>	<u>431</u>
<u>Sand</u>	<u>16</u>	<u>447</u>

Information upon completion of well:

(1) Diameter 1 1/4 inches.

(2) Total Depth 447 feet.

(3) Water Level + 6' 9" feet below top of ground.

(4) Cased to _____, Size _____.

(5) Screen: Size 1 1/4, Length 10'.


(6) Were any formations sealed against pollution?
 _____ yes, no.

If YES depth of formation _____

Why _____

Drillers Remarks: _____

CODED

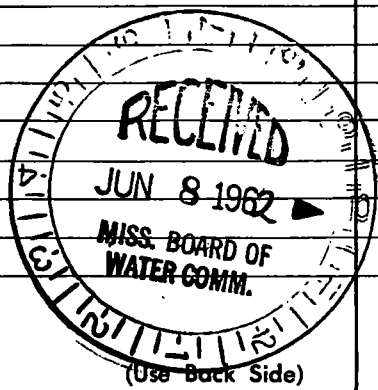

Well No. 295

