

JACKSON
 MISS
 2-18-70

MISSISSIPPI
 BOARD OF WATER COMMISSIONERS
 416 North State Street
 Jackson, Mississippi 39201

CODED

WATER WELL DRILLERS LOG

Feb 18 1970 Colwell Water Supply Jackson
 date well completed firm name county well located

LANDOWNER: Ernest Cross
Helena Miss.
 (mailing address)

WELL LOCATION:
 sec 29 T 6 N R 5 E
6 miles north of MP
 (distance) (direction) (nearest town)

WELL PURPOSE: Home
 (home, irrigation, municipal, industrial)

description of formations encountered	from	to
Clay	0	10
sand	10	146
Clay	146	155
sand	155	180
Clay	180	195
sand	195	202
Clay	202	242
sand	242	247
Clay	247	

WELL COMPLETION DATA:

(1) diameter (inches) 2

(2) total depth (feet) 440

(3) static water level (feet) 4 ^{below} top of ground

(4) casing galv (material) (depth) _____
 _____ (size) If telescope see back.

(5) screen 5' (length) (depth to top) _____
2" (size) stainless (material)

(6) pump 1 (HP) 10 (yield gpm)
elec (type power)

(7) electric log no (yes or no)
 _____ (organization running log)

(8) how well bottom plugged SP1 blue

CODED


MAR 25 1971

MISS. REG.
 WATER

DRILLERS REMARKS:

If well telescopes please sketch and show depths.

GROUND LEVEL

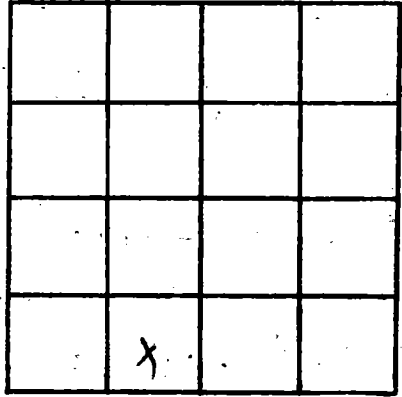

SECTION 29

Please indicate well location X.

ADDITIONAL INFORMATION

If more than one screen, show locations of each on sketch.