

JACKSON  
M 156  
3-15-71

MISSISSIPPI  
BOARD OF WATER COMMISSIONERS  
416 North State Street  
Jackson, Mississippi 39201

WATER WELL DRILLERS L

**CODED**


March 15 1971 Roboth Water Supply Jackson  
date well completed firm name county well located

LANDOWNER: <u>Salvadge</u> <u>Gasper</u>	description of formations encountered	from	to
<u>Helena Miss</u> (mailing address)	<u>clay</u>	<u>0</u>	<u>27</u>
WELL LOCATION:	<u>sand</u>	<u>27</u>	<u>71</u>
sec. <u>29</u> T. <u>6</u> N. R. <u>5</u> E. <u>7</u> miles <u>N</u> of <u>MP</u> (distance) (direction) (nearest town)	<u>clay</u>	<u>71</u>	<u>250</u>
WELL PURPOSE: <u>home</u> (home, irrigation, municipal, industrial)	<u>sand</u>	<u>250</u>	<u>270</u>
WELL COMPLETION DATA:			
(1) diameter (inches) <u>2</u>	<b>CODED</b>		
(2) total depth (feet) <u>270</u>			
(3) static water level (feet) <u>8-3</u> <sup>below</sup> above top of ground.			
(4) casing <u>galv</u> , <u>265</u> (material) (depth)			
(size) If telescope see back.			
(5) screen <u>5'</u> , <u>265</u> (length) (depth to top)			
<u>2"</u> , <u>stainless</u> (size) (material)			
(6) pump _____ (HP) (yield gpm)			
(type power)			
(7) electric log <u>no</u> (yes or no)			
(organization running log)			
(8) how well bottom plugged <u>B.P. Vally</u>			
DRILLERS REMARKS: <u>pump installed by owner</u>	MAR 25 1971		

MISS. BD. OF  
WATER COMM.

If well telescopes please sketch and show depths.

GROUND LEVEL

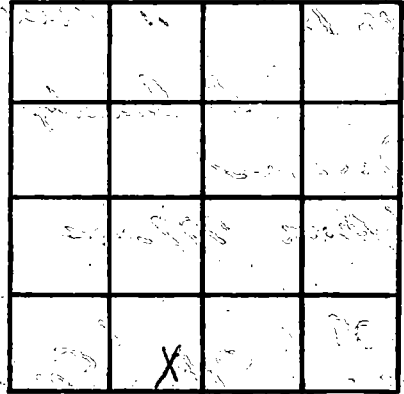

SECTION \_\_\_\_\_

Please indicate well location X.

ADDITIONAL INFORMATION

If more than one screen, show locations of each on sketch.