

JACKSON  
M 158  
6-4-71

MISSISSIPPI  
BOARD OF WATER COMMISSIONERS  
416 North State Street  
Jackson, Mississippi 39201

**CODED**

WATER WELL DRILLERS LOG

June 4 1971 Colville Water Supply Jackson  
date well completed firm name county well located

LANDOWNER: C. J. Walker  
Nolena Miss.  
(mailing address)

WELL LOCATION:  
sec. 10 T. 6 N R. 5 E  
10 miles NE of M.P.  
(distance) (direction) (nearest town)

WELL PURPOSE: home  
(home, irrigation, municipal, industrial)

WELL COMPLETION DATA:

(1) diameter (inches) 2

(2) total depth (feet) 342

(3) static water level (feet) 5 below top of ground above

(4) casing galv. 337 (material) (depth)

(size) If telescope see back.

(5) screen 51 337 (length) (depth to top)

24 Stain (size) (material)

(6) pump (HP) (yield gpm)

(type power)

(7) electric log No (yes or no)

(organization running log)

(8) how well bottom plugged B.P. Valve

description of formations encountered	depth	
	from	to
clay	0	18
sand & gravel	18	44
clay	44	48
sand	48	138
clay	138	248
sand	248	342

**CODED**


JUL 10 1971

MISS. BO. OF  
WATER COMM.

DRILLERS REMARKS:

If well telescopes please sketch and show depths.

GROUND LEVEL

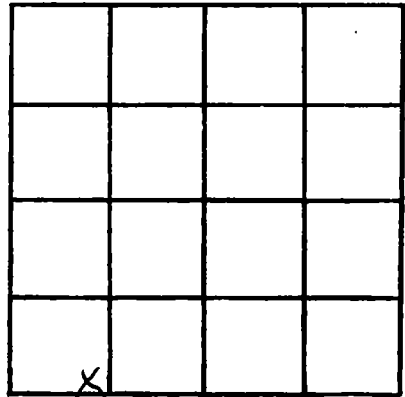

SECTION 10

Please indicate well location X.

ADDITIONAL INFORMATION

If more than one screen, show locations of each on sketch.