

JACKSON
M159
6-8-71

MISSISSIPPI
BOARD OF WATER COMMISSIONERS
416 North State Street
Jackson, Mississippi 39201

CODED

WATER WELL DRILLERS LOG

June 8 1971 *Corville Water Supply Jackson*
date well completed firm name county well located

LANDOWNER: <i>Carley Deer</i>	description of formations encountered	from	to
<i>Helena Miss</i> (mailing address)	<i>clay</i> <i>sand & gravel</i> <i>clay</i> <i>sermed</i>	0 44 88 550	44 22 88 573
<p>WELL LOCATION:</p> <p>sec. <u>36</u> T <u>6</u> N R <u>5</u> E <u>6</u> miles ^(N) North of ^(W) M.P. (distance) (direction) (nearest town)</p>			
<p>WELL PURPOSE: <i>Home</i> (home, irrigation, municipal, industrial)</p>			
<p>WELL COMPLETION DATA:</p> <p>(1) diameter (inches) <u>2</u></p> <p>(2) total depth (feet) <u>573</u></p> <p>(3) static water level (feet) <u>16</u> ^{below} above top of ground.</p> <p>(4) casing <u>galv</u> <u>568</u> (material) (depth)</p> <p>_____ if telescope see back. (size)</p> <p>(5) screen <u>5'</u> <u>568</u> (length) (depth to top)</p> <p><u>2</u> <u>stambor</u> (size) (material)</p> <p>(6) pump _____ (HP) (yield gpm)</p> <p>_____ (type power)</p> <p>(7) electric log <u>no</u> (yes or no)</p> <p>_____ (organization running log)</p> <p>(8) how well bottom plugged <u>BP valves</u></p>			
<p>DRILLERS REMARKS: <i>Pump installed by owner</i></p>			


CODED

JUL 19 1971

MISS. Bd. of
WATER COM.

If well telescopes please sketch and show depths.

GROUND LEVEL

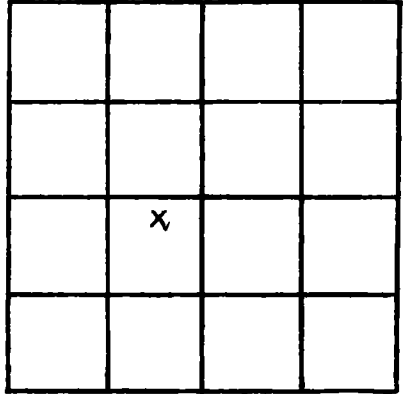

SECTION 31

Please indicate well location X.

ADDITIONAL INFORMATION

If more than one screen, show locations of each on sketch.