

JACKSON  
M161  
7-16-71

MISSISSIPPI  
BOARD OF WATER COMMISSIONERS  
416 North State Street  
Jackson, Mississippi 39201

**CODED**

WATER WELL DRILLERS LOG

July 16 1971 date well completed  
Calville Water Supply firm name  
Jackson county well located

LANDOWNER: <u>Charles</u>	description of formations encountered	from	to
<u>Aurby</u>	<u>clay</u>	<u>0</u>	<u>66</u>
<u>Helena Moore</u> (mailing address)	<u>sand</u>	<u>66</u>	<u>89</u>
<b>WELL LOCATION:</b>			
sec. <u>28</u> T- <u>6</u> N R- <u>5</u> E			
<u>7</u> miles <u>NE</u> of <u>MP</u> (distance) (direction) (nearest town)			
<b>WELL PURPOSE:</b> <u>Home</u> (home, irrigation, municipal, industrial)			
<b>WELL COMPLETION DATA:</b>			
(1) diameter (inches) <u>2</u>			
(2) total depth (feet) <u>89</u>			
(3) static water level (feet) <u>15</u> <u>below</u> above top of ground.			
(4) casing <u>galv.</u> , <u>84</u> (material) (depth)			
(size) If telescope see back.			
(5) screen <u>5</u> , <u>84</u> (length) (depth to top)			
<u>2</u> , <u>stainless</u> (size) (material)			
(6) pump _____ (HP) _____ (yield gpm)			
(type power)			
(7) electric log <u>no</u> (yes or no)			
(organization running log)			
(8) how well bottom plugged <u>OK</u>			
<b>DRILLERS REMARKS:</b> <u>pump installed by owner</u>			


**CODED**

JUL 19 1971

MISS. BD. OF  
WATER COMM.

If well telescopes please sketch and show depths.

GROUND LEVEL

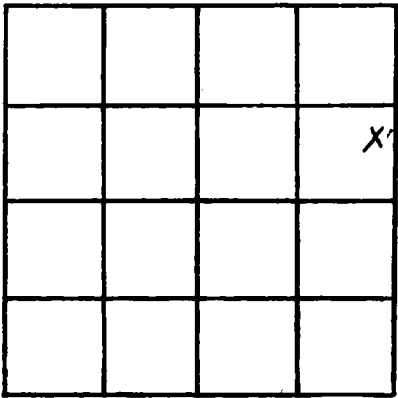

SECTION 28

Please indicate well location X.

ADDITIONAL INFORMATION

If more than one screen,  
show locations of each on sketch.