

JACKSON
M 162
3-22-71

MISSISSIPPI
BOARD OF WATER COMMISSIONERS 21 1971
416 North State Street
Jackson, Mississippi 39201

MISS. BD. OF
WATER COMMISSIONERS

WATER WELL DRILLERS LOG

CODED

March 22 1971 Mobile Water Supply
date well completed firm name county well located

LANDOWNER: J. J. Stungen
Big Point, Miss.
(mailing address)

description of formations encountered	from	to
Clay	0	10
sand	10	115
Clay	115	264
sand	264	295
Clay	295	452
sand	452	525

WELL LOCATION:
sec. 11 T. 6 N R. 5 E
9 miles NE of MP
(distance) (direction) (nearest town)

WELL PURPOSE: domestic
(home, irrigation, municipal, industrial)

WELL COMPLETION DATA:

(1) diameter (inches) 2"

(2) total depth (feet) 525

(3) static water level (feet) 11-6 below top of ground. above

(4) casing Galv, 515
(material) (depth)

(size) if telescope see back.

(5) screen 10', 515
(length) (depth to top)

(size) 2, Stainless
(size) (material)

(6) pump no pump
(HP) (yield gpm)

(type power)

(7) electric log no
(yes or no)

(organization running log)

(8) how well bottom plugged BP Valve


CODED

DRILLERS REMARKS:

If well telescopes please sketch and show depths.

GROUND LEVEL

Well drilled on road
not ~~shown~~ pictured on
our maps,

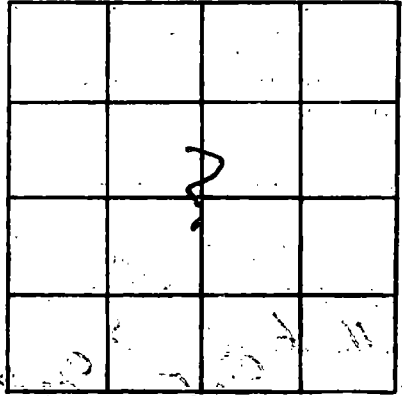

SECTION 11

Please indicate well location X.

ADDITIONAL INFORMATION

If more than one screen,
show locations of each on sketch.