

JACKSON  
M163  
9-23-71


MISSISSIPPI  
BOARD OF WATER COMMISSIONERS 21  
416 North State Street  
Jackson, Mississippi 39201  
WATER WELL DRILLERS  
**CODED** MISS. BD. OF COMM.

Sept 23 1971 Calville Water Supply JACKSON  
date well completed firm name county well located

LANDOWNER: <u>DOUG Cronier</u>	description of formations encountered	from	to
Helena Miss (mailing address)	Clay	0	10
WELL LOCATION:	sand	10	69
sec. <u>35</u> T. <u>6</u> N R. <u>5</u> E	Clay	69	182
6 miles <u>NE</u> of <u>MissPicot</u> (distance) (direction) (nearest town)	sand	111	183
WELL PURPOSE: <u>Home</u> (home, irrigation, municipal, industrial)	Clay	193	1032
WELL COMPLETION DATA:	sand	1032	1052
(1) diameter (inches) <u>2</u>	<b>CODED</b>		
(2) total depth (feet) <u>1059</u>			
(3) static water level (feet) <u>12</u> <u>below</u> top of ground. <u>above</u>			
(4) casing <u>galv</u> <u>1049</u> (material) (depth)			
<u>      </u> If telescope see back. (size)			
(5) screen <u>10</u> <u>1049</u> (length) (depth to top)			
<u>2</u> <u>stainless</u> (size) (material)			
(6) pump <u>no pump</u> (HP) (yield gpm)			
<u>      </u> (type power)			
(7) electric log <u>no</u> (yes or no)			
<u>      </u> (organization running log)			
(8) how well bottom plugged <u>B.P. Valve</u>			
DRILLERS REMARKS:			

If well telescopes please sketch and show depths.

GROUND LEVEL

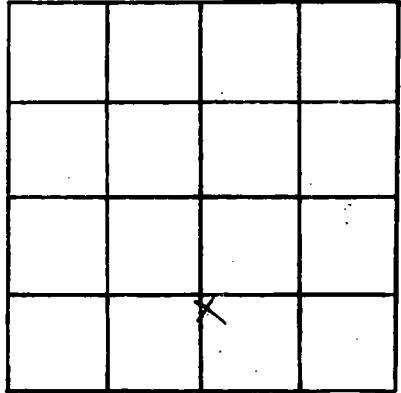

SECTION 35

Please indicate well location X.

**ADDITIONAL INFORMATION**

---

---

If more than one screen, show locations of each on sketch.