

JACKSON  
M 164  
10-11-71

MISSISSIPPI  
BOARD OF WATER COMMISSIONERS SEC 21  
416 North State Street  
Jackson, Mississippi 39201

MISS. BD. OF  
WATER COMM

WATER WELL DRILLER

**CODED**

Oct 11 1971 date well completed  
Colville Water Supply firm name  
Jackson county well located

LANDOWNER: Mrs  
B. W. Meadows  
Helena  
(mailing address)

description of formations encountered	from	to
Clay	0	16
Sand	16	61
Clay	61	75
Sand	75	120

WELL LOCATION:  
sec. 29 T. 6 N R. 5 E  
6 miles NE of MP  
(distance) (direction) (nearest town)

WELL PURPOSE: home  
(home, irrigation, municipal, industrial)

WELL COMPLETION DATA:

(1) diameter (inches) 7

(2) total depth (feet) 120

(3) static water level (feet) 5 below above top of ground.

(4) casing plastic, 11 1/2 (material) (depth)

(size) If telescope see back.

(5) screen 4' (length) 116 (depth to top)

2 plastic (size) (material)

(6) pump 1 (HP) 21 (yield gpm)

elec (type power)

(7) electric log no (yes or no)

(organization running log)


(8) how well bottom plugged BP valve

**CODED**

DRILLERS REMARKS:

If well telescopes please sketch and show depths.

GROUND LEVEL

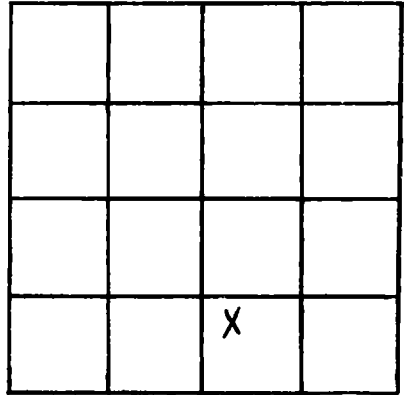

SECTION 29

Please indicate well location X.

ADDITIONAL INFORMATION

If more than one screen, show locations of each on sketch.