

JACKSON
M 167
11-29-71

MISSISSIPPI
BOARD OF WATER COMMISSION
416 North State Street
Jackson, Mississippi 39201

NOV 29 1971
CODED

WATER WELL DRILLERS LOG


Nov 29 1971 Colville W.S. JACKSON
date well completed firm name county well located

LANDOWNER: <u>D. L. Barfield</u>	description of formations encountered	from	to
<u>Helena</u> (mailing address)	<u>clay</u>	<u>0</u>	<u>16</u>
	<u>SAND</u>	<u>16</u>	<u>72</u>
	<u>clay</u>	<u>72</u>	<u>243</u>
	<u>SAND</u>	<u>243</u>	<u>279</u>
WELL LOCATION: sec <u>29</u> T <u>6</u> N R <u>5</u> E <u>6</u> miles <u>North</u> of <u>M.P.</u> (distance) (direction) (nearest town)			
WELL PURPOSE: <u>home</u> (home, irrigation, municipal, industrial)			
WELL COMPLETION DATA:			
(1) diameter (inches) <u>2</u>			
(2) total depth (feet) <u>279</u>			
(3) static water level (feet) <u>10</u> ^{below} above top of ground.			
(4) casing <u>SMU</u> <u>274</u> (material) (depth)			
(5) screen <u>51</u> <u>274</u> (length) (depth to top)			
<u>2</u> <u>STAIN</u> (size) (material)			
(6) pump _____ (HP) (yield gpm)			
(type power)			
(7) electric log <u>NO</u> (yes or no)			
(organization running log)			
(8) how well bottom plugged <u>BP value</u>			
DRILLERS REMARKS: <u>pump installed by owner</u>			

CODED

If well telescopes please sketch and show depths.

GROUND LEVEL

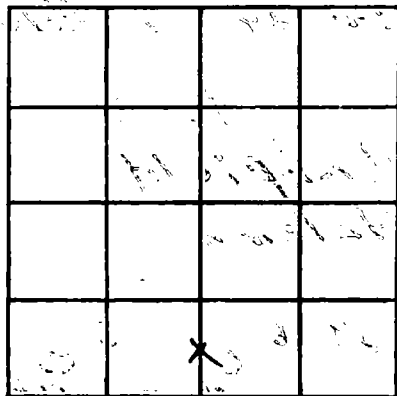

SECTION 29

Please indicate well location X.

ADDITIONAL INFORMATION

A series of horizontal lines for writing additional information.

If more than one screen, show locations of each on sketch.