

JACKSON
M168
1-26-72

MISSISSIPPI
 BOARD OF WATER COMMISSIONERS
 416 North State Street
 Jackson, Mississippi 39201

FEB - 9 1972

MISS. BO. OF
 WATER COM.

WATER WELL DRILLERS LOG


Jan 26 1972 Colville Water Supply Jackson
 date well completed firm name county well located

LANDOWNER: <u>Larry Young</u>	description of formations encountered	from	to
<u>Helena Miss</u> (mailing address)	<u>Clay</u>	<u>0</u>	<u>14</u>
	<u>Sand</u>	<u>16</u>	<u>90</u>
	<u>Clay</u>	<u>90</u>	<u>145</u>
WELL LOCATION: sec. <u>29</u> T. <u>6</u> N. R. <u>5</u> E. <u>5</u> miles <u>NE</u> of <u>M.P.</u> (distance) (direction) (nearest town)			
WELL PURPOSE: <u>Home</u> (home, irrigation, municipal, industrial)			
WELL COMPLETION DATA:			
(1) diameter (inches) <u>2</u>			
(2) total depth (feet) <u>154</u>			
(3) static water level (feet) <u>12</u> <u>below</u> top of ground.			
(4) casing <u>GAIR</u> , <u>149</u> (material) (depth)			
(size) If telescope see back.			
(5) screen <u>5'</u> , <u>149</u> (length) (depth to top)			
<u>2"</u> , <u>STAINLESS</u> (size) (material)			
(6) pump <u>1/2</u> , <u>10</u> (HP) (yield gpm)			
<u>elec</u> (type power)			
(7) electric log <u>no</u> (yes or no)			
(organization running log)			
(8) how well bottom plugged <u>BP Valve</u>			
DRILLERS REMARKS:			

CODED

If well telescopes please sketch and show depths.

GROUND LEVEL

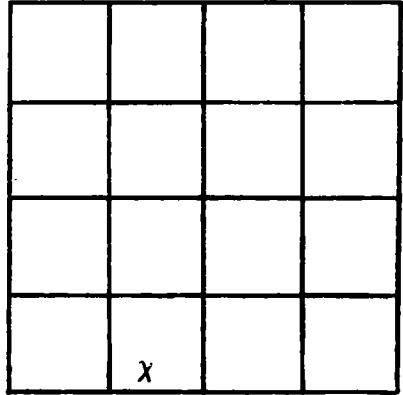

SECTION 29

Please indicate well location X.

ADDITIONAL INFORMATION

If more than one screen, show locations of each on sketch.