

JACKSON
M 169
1-15-72

MISSISSIPPI
 BOARD OF WATER COMMISSIONERS
 416 North State Street
 Jackson, Mississippi 39201
WATER WELL DRILLERS LOG

MISS. REG. NO.
 1-15-72


JAN 15 19 72 Colville Water Supply Jackson
 date well completed firm name county well located

LANDOWNER: <u>JAMES</u>	description of formations encountered	from	to
SUMMERALL <u>SUMMERALL</u>			
<u>Melena Miss</u> (mailing address)	<u>soft clay</u>	<u>0</u>	<u>18</u>
	<u>clay str and SAND</u>	<u>18</u>	<u>210</u>
	<u>clay</u>	<u>210</u>	<u>220</u>
	<u>SAND</u>	<u>220</u>	<u>276</u>
WELL LOCATION:			
sec. <u>29</u> T. <u>6</u> N R. <u>5</u> E			
<u>5</u> miles <u>NW</u> of <u>M.P.</u>			
(distance) (direction) (nearest town)			
WELL PURPOSE: <u>Home</u> (home, irrigation, municipal, industrial)			
WELL COMPLETION DATA:			
(1) diameter (inches) <u>2</u>			
(2) total depth (feet) <u>276</u>			
(3) static water level (feet) <u>3</u> <u>below</u> above top of ground.			
(4) casing <u>Galv</u> , <u>271</u> (material) (depth)			
_____ If telescope see back. (size)			
(5) screen <u>5'</u> , <u>271</u> (length) (depth to top)			
<u>2"</u> , <u>Stainless</u> (size) (material)			
(6) pump _____ (HP) _____ (yield gpm)			
_____ (type power)			
(7) electric log <u>No</u> (yes or no)			
_____ (organization running log)			
(8) how well bottom plugged <u>BP Valve</u>			
DRILLERS REMARKS: <u>PUMP</u> <u>Installed by owner</u>			

CODED

If well telescopes please sketch and show depths.

GROUND LEVEL

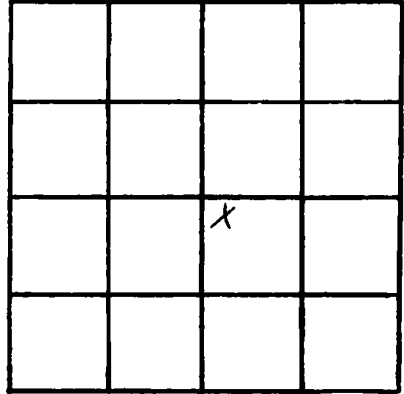

SECTION 29

Please indicate well location X.

ADDITIONAL INFORMATION

If more than one screen, show locations of each on sketch.