

JACKSON
M 173
2-25-72

MISSISSIPPI
BOARD OF WATER COMMISSIONERS

410 North State Street
Jackson, Mississippi 39201

MAR 22 1972

WATER WELL DRILLERS LOG

2-25 1972 Coast Water Well Serv. Jackson
date well completed firm name county well located


LANDOWNER:	description of formations encountered	from	to
<u>Helene Mrs.</u> <u>Church - Rt. 3</u>	<u>top soil</u>	<u>0</u>	<u>15</u>
<u>Pascagoula Miss.</u> (mailing address)	<u>sand fine to med.</u>	<u>15</u>	<u>74</u>
WELL LOCATION: sec. <u>29</u> T. <u>6</u> N R. <u>5</u> W <u>7</u> miles <u>N</u> of <u>Miss Point</u> (distance) (direction) (nearest town)	<u>blue clay</u>	<u>74</u>	<u>147</u>
	<u>fine sand</u>	<u>147</u>	<u>220</u>
WELL PURPOSE: <u>Church</u> (home, irrigation, municipal, industrial)	<u>blue clay</u>	<u>220</u>	<u>245</u>
WELL COMPLETION DATA:	<u>sand fine to med.</u>	<u>245</u>	<u>262</u>
(1) diameter (inches) <u>2"</u>			
(2) total depth (feet) <u>262</u>			
(3) static water level (feet) <u>6</u> below top of ground.			
(4) casing <u>galv.</u> (material), <u>252'</u> (depth)			
<u>2"</u> (size) if telescope see back.			
(5) screen <u>10'</u> (length), <u>252'</u> (depth to top)			
<u>2"</u> (size), <u>stainless steel</u> (material)			
(6) pump <u>1/2</u> (HP), <u>9</u> (yield gpm)			
<u>elec.</u> (type power)			
(7) electric log <u>no</u> (yes or no)			
(organization running log)			
(8) how well bottom plugged <u>back</u> <u>wash valve</u>			
DRILLERS REMARKS:			

CODED

CODED

If well telescopes please sketch and show depths.

GROUND LEVEL

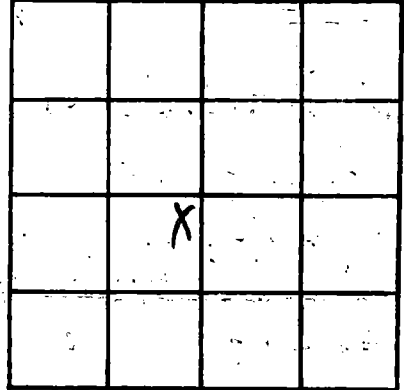

SECTION 29

Please indicate well location X.

ADDITIONAL INFORMATION

Lined area for additional information.

If more than one screen, show locations of each on sketch.