

JACKSON
 M 176
 3-15-72

MISSISSIPPI
 BOARD OF WATER COMMISSIONERS
 416 North State Street
 Jackson, Mississippi 39201

CODED

WATER WELL DRILLERS LOG

Mar 15 1972 Polville Water Sup. Jackson
 date well completed firm name county well located

LANDOWNER: B. N. Smith
Ports Lake Mills
 (mailing address)

WELL LOCATION:
 sec 12 T 6 N R 4 E
10 miles NE of M.P.
 (distance) (direction) (nearest town)

| description of formations encountered | from | to |
|---------------------------------------|------|-----|
| Sandy clay | 0 | 32 |
| clay | 32 | 90 |
| Sand | 90 | 124 |
| clay | 124 | 270 |
| Sand | 270 | 300 |

WELL PURPOSE: home
 (home, irrigation, municipal, industrial)

WELL COMPLETION DATA:

(1) diameter (inches) 2

(2) total depth (feet) 300

(3) static water level (feet) 11-4 ^{below} above top of ground.

(4) casing galv, 295
 (material) (depth)

(size) If telescope see back.

(5) screen 5', 295
 (length) (depth to top)

2, STAINLESS
 (size) (material)

(6) pump _____ (HP) _____ (yield gpm)

(type power)

(7) electric log NO
 (yes or no)

(organization running log)

(8) how well bottom plugged APIAIVE

CODED


MAY 24 1972

MISS. BD. OF
 WATER COMM.

DRILLERS REMARKS: pump installed by owner

If well telescopes please sketch and show depths.

GROUND LEVEL

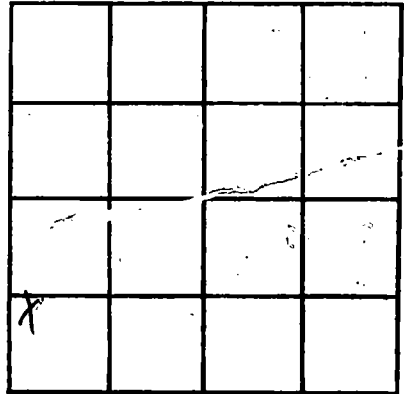

SECTION 17

Please indicate well location X.

ADDITIONAL INFORMATION

If more than one screen, show locations of each on sketch.