

JACKSON
M179
2-11-72

MISSISSIPPI
BOARD OF WATER COMMISSIONERS
416 North State Street
Jackson, Mississippi 39201

CODED


WATER WELL DRILLERS LOG

Feb 11 1972 data well completed Colville Water Supply firm name JACKSON county well located

| LANDOWNER: <u>LARRY KORAG</u> | description of formations encountered | from | to |
|---|---------------------------------------|------------|------------|
| <u>Helena Miss</u> (mailing address) | <u>Clay</u> | <u>0</u> | <u>5</u> |
| WELL LOCATION: sec <u>29</u> T <u>6</u> N R <u>5</u> E <u>7</u> miles <u>NE</u> of <u>M.P.</u> (distance) (direction) (nearest town) | <u>SAND</u> | <u>5</u> | <u>72</u> |
| WELL PURPOSE: <u>home</u> (home, irrigation, municipal, industrial) | <u>clay</u> | <u>72</u> | <u>146</u> |
| WELL COMPLETION DATA: (1) diameter (inches) <u>2</u> | <u>SAND</u> | <u>146</u> | <u>154</u> |
| (2) total depth (feet) <u>154</u> | CODED | | |
| (3) static water level (feet) _____ below above top of ground. | | | |
| (4) casing <u>Galv</u> <u>149</u> (material) (depth) | | | |
| (size) If telescope see back. | | | |
| (5) screen <u>5'</u> <u>149</u> (length) (depth to top) | | | |
| <u>2</u> <u>Stainless</u> (size) (material) | | | |
| (6) pump <u>1/2</u> <u>10</u> (HP) (yield gpm) | | | |
| <u>elec</u> (type power) | | | |
| (7) electric log <u>NO</u> (yes or no) | MAY 24 1972 | | |
| (8) how well bottom plugged <u>BP Valve</u> | | | |
| DRILLERS REMARKS: | MISS. DEPT. OF WATER RES. | | |

If well telescopes please sketch and show depths.

GROUND LEVEL

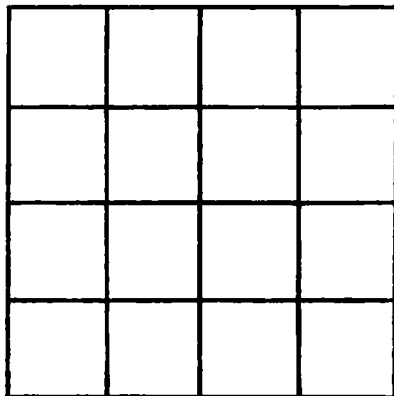

SECTION _____

Please indicate well location X.

ADDITIONAL INFORMATION

If more than one screen, show locations of each on sketch.