

JACKSON
M 180
4-10-72

MISSISSIPPI
BOARD OF WATER COMMISSIONERS
416 North State Street
Jackson, Mississippi 39201

WATER WELL DRILLERS LOG

CODED

April 10 1972 Calville Water Sup. JACKSON
date well completed firm name county well located

LANDOWNER: LARRY
Young
Helena Ms
(mailing address)
WELL LOCATION:
sec. 27 T 6 N R 5 E
7 miles NE of M.P.
(distance) (direction) (nearest town)

description of formations encountered	from	to
Clay	0	15
Sand	15	69
Clay	69	110
Sand	110	131

WELL PURPOSE: Home
(home, Irrigation, municipal, industrial)

WELL COMPLETION DATA:
(1) diameter (inches) 2
(2) total depth (feet) 131
(3) static water level (feet) 8 below above top of ground.
(4) casing galv 126
(material) (depth)
126 If telescope see back.
(size) 5' 105
(5) screen (length) (depth to top)
2" STAINLESS
(size) (material)
(6) pump 1/2 6
(HP) (yield gpm)
elec
(type power)
(7) electric log NO
(yes or no)
(organization running log)
(8) how well bottom plugged BPV/valop


CODED

APR 24 1972
MISSISSIPPI
STATE

DRILLERS REMARKS:

If well telescopes please sketch and show depths.

GROUND LEVEL

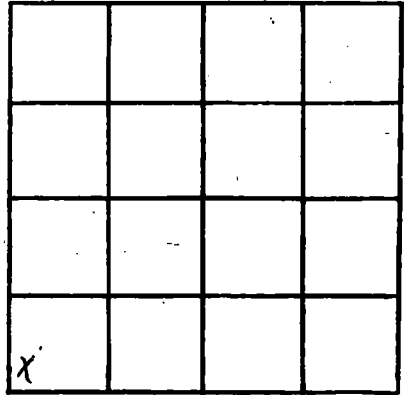

SECTION 29

Please indicate well location X.

ADDITIONAL INFORMATION

If more than one screen, show locations of each on sketch.