

JACKSON
M182
2-22-72

MISSISSIPPI
BOARD OF WATER COMMISSIONERS
416 North State Street
Jackson, Mississippi 39201

WATER WELL DRILLERS LOG

CODED

Feb 22 1972 data well completed
72 Colville Water Supply firm name
JACKSON county well located

LANDOWNER: DENZIL HARRISON
Merced Miss
(mailing address)

description of formations encountered	from	to
clay	0	48
SAND	48	126
clay	126	270
Sand	270	303

WELL LOCATION:
sec. 9 T. 6 N. R. 5 E.
9 miles NK (direction) of MP (nearest town)

WELL PURPOSE: HOME
(home, irrigation, municipal, industrial)

WELL COMPLETION DATA:

(1) diameter (inches) 2"

(2) total depth (feet) 303

(3) static water level (feet) 11 below top of ground

(4) casing galv (material), 298 (depth)

 if telescope see back.
(size)

(5) screen 5 ft (length), 298 (depth to top)

3" (size), STAINLESS (material)

(6) pump (HP) (yield gpm)

 (type power)

(7) electric log No (yes, or no)

 (organization running log)

(8) how well bottom plugged excellent

CODED


MAY 24 1972

MISS. BD. OF WATER COMMISSIONERS

DRILLERS REMARKS: PUMP installed by owner

If well telescopes please sketch and show depths.

GROUND LEVEL

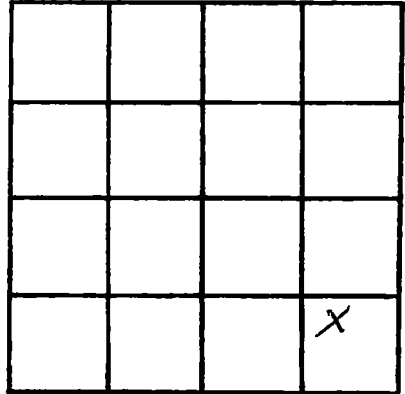

SECTION 8

Please indicate well location X.

ADDITIONAL INFORMATION

If more than one screen, show locations of each on sketch.