

JACKSON
M 185
5-5-72

MISSISSIPPI
BOARD OF WATER COMMISSIONERS
416 North State Street
Jackson, Mississippi 39201

CODED

WATER WELL DRILLERS LOG

May 5 1971 Collette W. S. Jackson
date well completed firm name county well located

LANDOWNER: Larry Young
Helen, Miss.

description of formations encountered	from	to
Clay	6	15
sand	15	80
clay	80	174
sand	174	195

(mailing address)

WELL LOCATION:
sec. 11 T. 6 N R. 5 E
3 miles NE of Meridian
(distance) (direction) (nearest town)

WELL PURPOSE: home
(home, irrigation, municipal, industrial)

- WELL COMPLETION DATA:
- (1) diameter (inches) 2
 - (2) total depth (feet) 195
 - (3) static water level (feet) 8 below above top of ground.
 - (4) casing galv 190
(material) (depth)
(size) if telescope see back.
 - (5) screen 5' 190
(length) (depth to top)
2" 2' diam.
(size) (material)
 - (6) pump (HP) (yield gpm)
(type power)
 - (7) electric log NO
(yes or no)
(organization running log)
 - (8) how well bottom plugged R.P. Valve

CODED


SEP 28 1972

MISS. DEPT. OF
WATER CONTROL

DRILLERS REMARKS: pump installed by owner

If well telescopes please sketch and show depths.

GROUND LEVEL

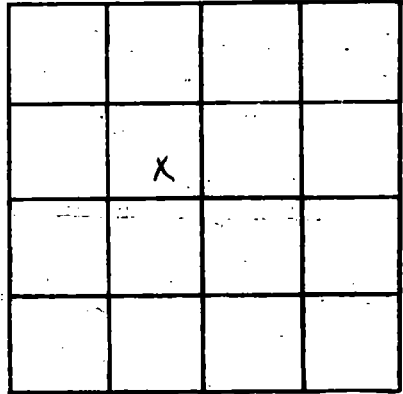

SECTION 11

Please indicate well location X.

ADDITIONAL INFORMATION

If more than one screen, show locations of each on sketch.