

JACKSON
 M186
 6-25-72

MISSISSIPPI
 BOARD OF WATER COMMISSIONERS
 416 North State Street
 Jackson, Mississippi 39201
 WATER WELL DRILLERS LOG

CODED

June 26 1972 C. Colville, Inc. Jackson
 date well completed firm name county well located

LANDOWNER: Major W. A. Green
Helena, Miss.
 (mailing address)

| description of formations encountered | from | to |
|---------------------------------------|------|-----|
| O. clay | 0 | 30 |
| Sand | 30 | 110 |
| Sand & clay | 110 | 172 |
| S&S sand | 172 | 230 |
| Clay | 230 | 652 |
| Sand | 652 | 670 |

WELL LOCATION:
 sec 8 T 6 N R 5 E
8 miles N of Marionville
 (distance) (direction) (nearest town)

WELL PURPOSE: Trailer Park
 (home, irrigation, municipal, industrial)

- WELL COMPLETION DATA:
- diameter (inches) 4 X 2
 - total depth (feet) 670
 - static water level (feet) 39 ^{below}/_{above} top of ground.
 - casing Steel 655
 (material) (depth)
 (size) if telescope see back.
 - screen 15' 670
 (length) (depth to top)
2" stainless
 (size) (material)
 - pump 3 60
 (HP) (yield gpm)
elec.
 (type power)
 - electric log Yes
 (yes or no)
B.
 (organization running log)
 - how well bottom plugged B.R.

CODED


SEP 20 1972

MISS. BD. OF
 WATER COMMISSIONERS

DRILLERS REMARKS:

If well telescopes please sketch and show depths.

GROUND LEVEL

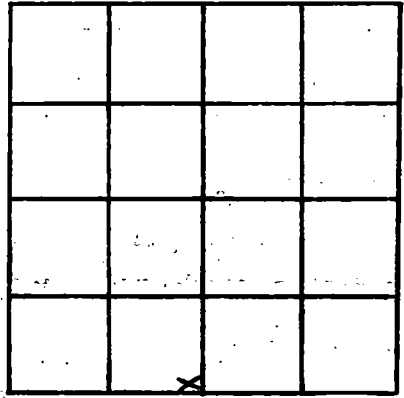

SECTION 2

Please indicate well location X.

ADDITIONAL INFORMATION

A series of horizontal lines providing space for additional information, located below the 'ADDITIONAL INFORMATION' header.

(mirrored text)

If more than one screen, show locations of each on sketch.