

JACKSON
M 189
10-16-72

MISSISSIPPI
BOARD OF WATER COMMISSIONERS
416 North State Street
Jackson, Mississippi 39201


WATER WELL DRILLERS LOG

Oct 16 1972 Cobble Water Supply Jackson
date well completed firm name county well located

LANDOWNER: <u>Elynn Davis</u>	description of formations encountered	from	to
Helena Ms (mailing address)	<u>Sandy clay</u>	0	16
	<u>Sand</u>	16	55
	<u>Clay</u>	55	106
	<u>Sand</u>	106	149
WELL LOCATION: sec. <u>27</u> T- <u>6</u> N R- <u>5</u> E <u>8</u> miles <u>North</u> of <u>N.M.P.</u> (distance) (direction) (nearest town)			
WELL PURPOSE: <u>Home</u> (home, irrigation, municipal, industrial)			
WELL COMPLETION DATA:			
(1) diameter (inches) <u>2"</u>			
(2) total depth (feet) <u>149</u>			
(3) static water level (feet) <u>14</u> <u>below</u> above top of ground.			
(4) casing <u>galv.</u> <u>144</u> (material) (depth)			
(size) If telescope see back.			
(5) screen <u>5'</u> <u>144</u> (length) (depth to top)			
<u>2"</u> <u>stainless</u> (size) (material)			
(6) pump <u>1</u> <u>10</u> (HP) (yield gpm)			
<u>1/2 HP</u> (type power)			
(7) electric log <u>no</u> (yes or no)			
(organization running log)			
(8) how well bottom plugged <u>B.P. down</u>			
DRILLERS REMARKS:			

If well telescopes please sketch and show depths.

GROUND LEVEL

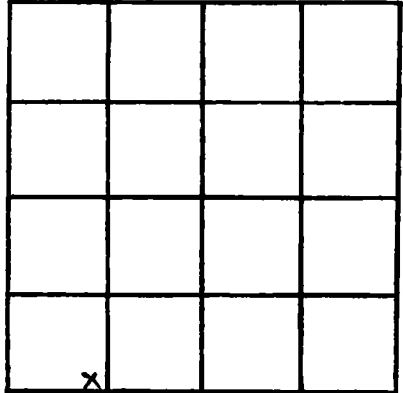

SECTION 29

Please indicate well location X.

ADDITIONAL INFORMATION

If more than one screen, show locations of each on sketch.